



GENERAL NOTES

- This drawing is indicative only (not to be used for construction)and is accurate as at the date shown on the drawing .
- This drawing is subject to change as planning , development and construction continues through until opening of the center .
- It is the responsibility of the recipient of this drawing to update themselves with any subsequent reviews , updates , additions , deletions and / or substitution .
- It is the responsibility of the investor to undertake an on-site measure to verify all dimension shown on the drawing .
- Tamdeen Shopping Centers CO K.S.C.C. (or any of it's affiliated companies) does not accept any liability of any form for the recipient's use and / or interpretation of this drawing.

NORTH DIRECTION

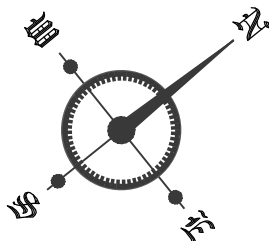


KEY PLAN

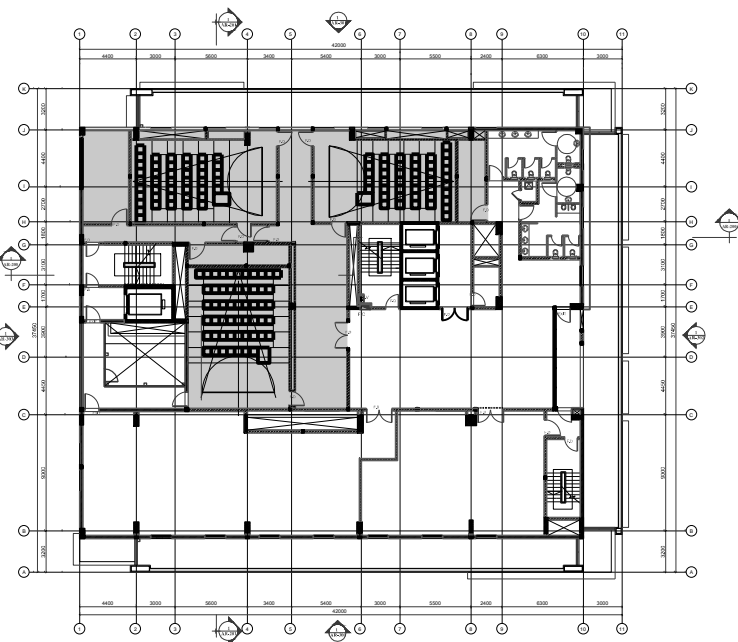

AS BUILT

OWNER : 

MANAGE BY  GLA Property Management Co (LLC)
P.O.Box 29060, Safat 13151, Kuwait
+965 2536 9531 Tel
+965 2530 9531 Fax
rdd@gl.ae

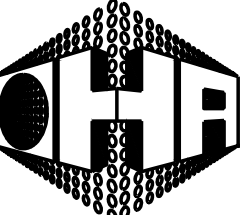CONSULTANT :  **مكتب عومة الاستشارات الهندسية**
OHA ENGINEERING CONSULTANT
P.O.Box 6049 HAWALLI , CODE NO.32037 - KUWAIT
PHONE: 22420508 - 22420518 FAX: 22436511
E-mail oha@ohaconsult.com

PROJECT NAME :
SAMA JAHRA

DRAWING TITLE :
FIRST FLOOR PLAN

CINEMA UNIT NO - L1-03,4,5,6,7,8 WATER SUPPLY SYSTEM		
DRAWN :	DESIGN :	DATE : MAR-2017
SCALE : 1:50@A1	REVISED BY :	PAPER SIZE : A1
TRADE MECH WS-01	REV. : 04	

