


SECTION A-A

SCALE 1:50

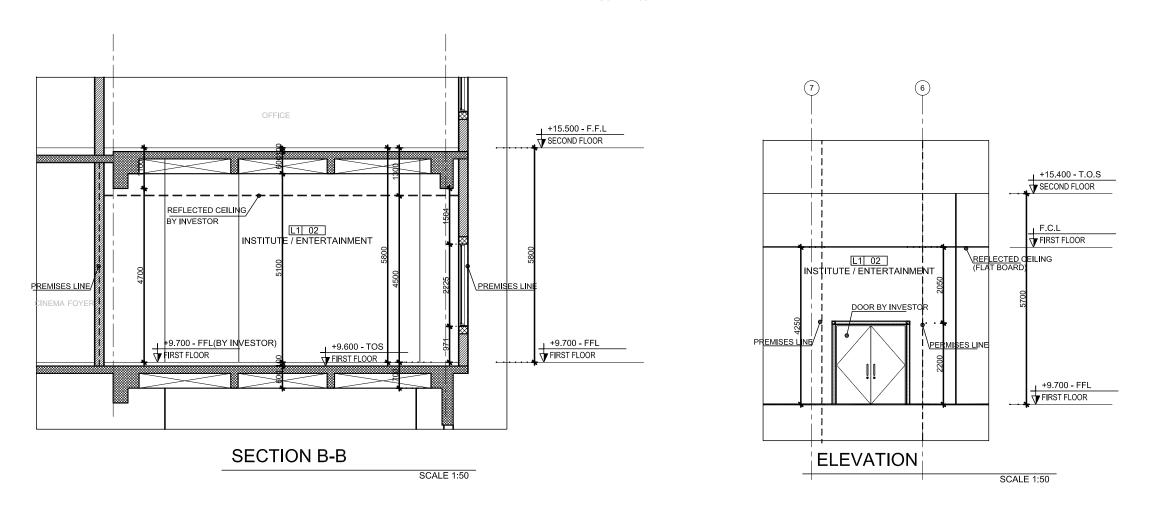


GENERAL NOTES

- This drawing is indicative only (not to be used for construction)and is accurate as at the date shown on
- This drawing is subject to change as planning , development and construction continues through until opening of the center .
- It is the responsibility of the recipient of this drawing to update themselves with any subsequent reviews, updates, additions, deletions and / or substitution.
- It is the responsibility of the investor to undertake an on-site measure to verify all dimension shown on the drawing.
- Tamdeen Shopping Centers CO K.S.C.C. (or any of it's affiliated companies) does not accept any liability of any form for the recipient's use and / or interpretation of this drawing.

NORTH DIRECTION



KEY PLAN

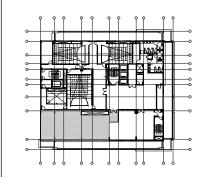

AS BUILT

OWNER:



MANAGE BY



GLA Property Management Co (LLC) P O Box 29060, Safat 13151,Kuwalt +965 2536 9531 Tel +965 2530 9531 Fax

CONSULTANT:



OHA ENGINEERING CONSULTANT
PHONE: 22420508 - 22420518 FAX: 22436511
PHONE: 243674 FAX: 2436711

PROJECT NAME:

SAMA JAHRA

DRAWING TITLE:

ARCH - SEC/ELEV-02

FIRST FLOOR PLAN

INSTITUTE / ENTERTAINMENT UNIT NO - L1-02

	DRAWN:	DESIGN:	DATE: MAR - 2017	
	SCALE: 1:50@A1	REVISED BY:	PAPER SIZE :	A1
	TRADE		REV.:	