


S.NO	DESCRIPTION	LOAD IN K.W
1	LIGHT	1.23 K.W
2	POWER	1.00 K.W
3	A/C	6.71 K.W
	TOTAL LOAD	8.94 K.W

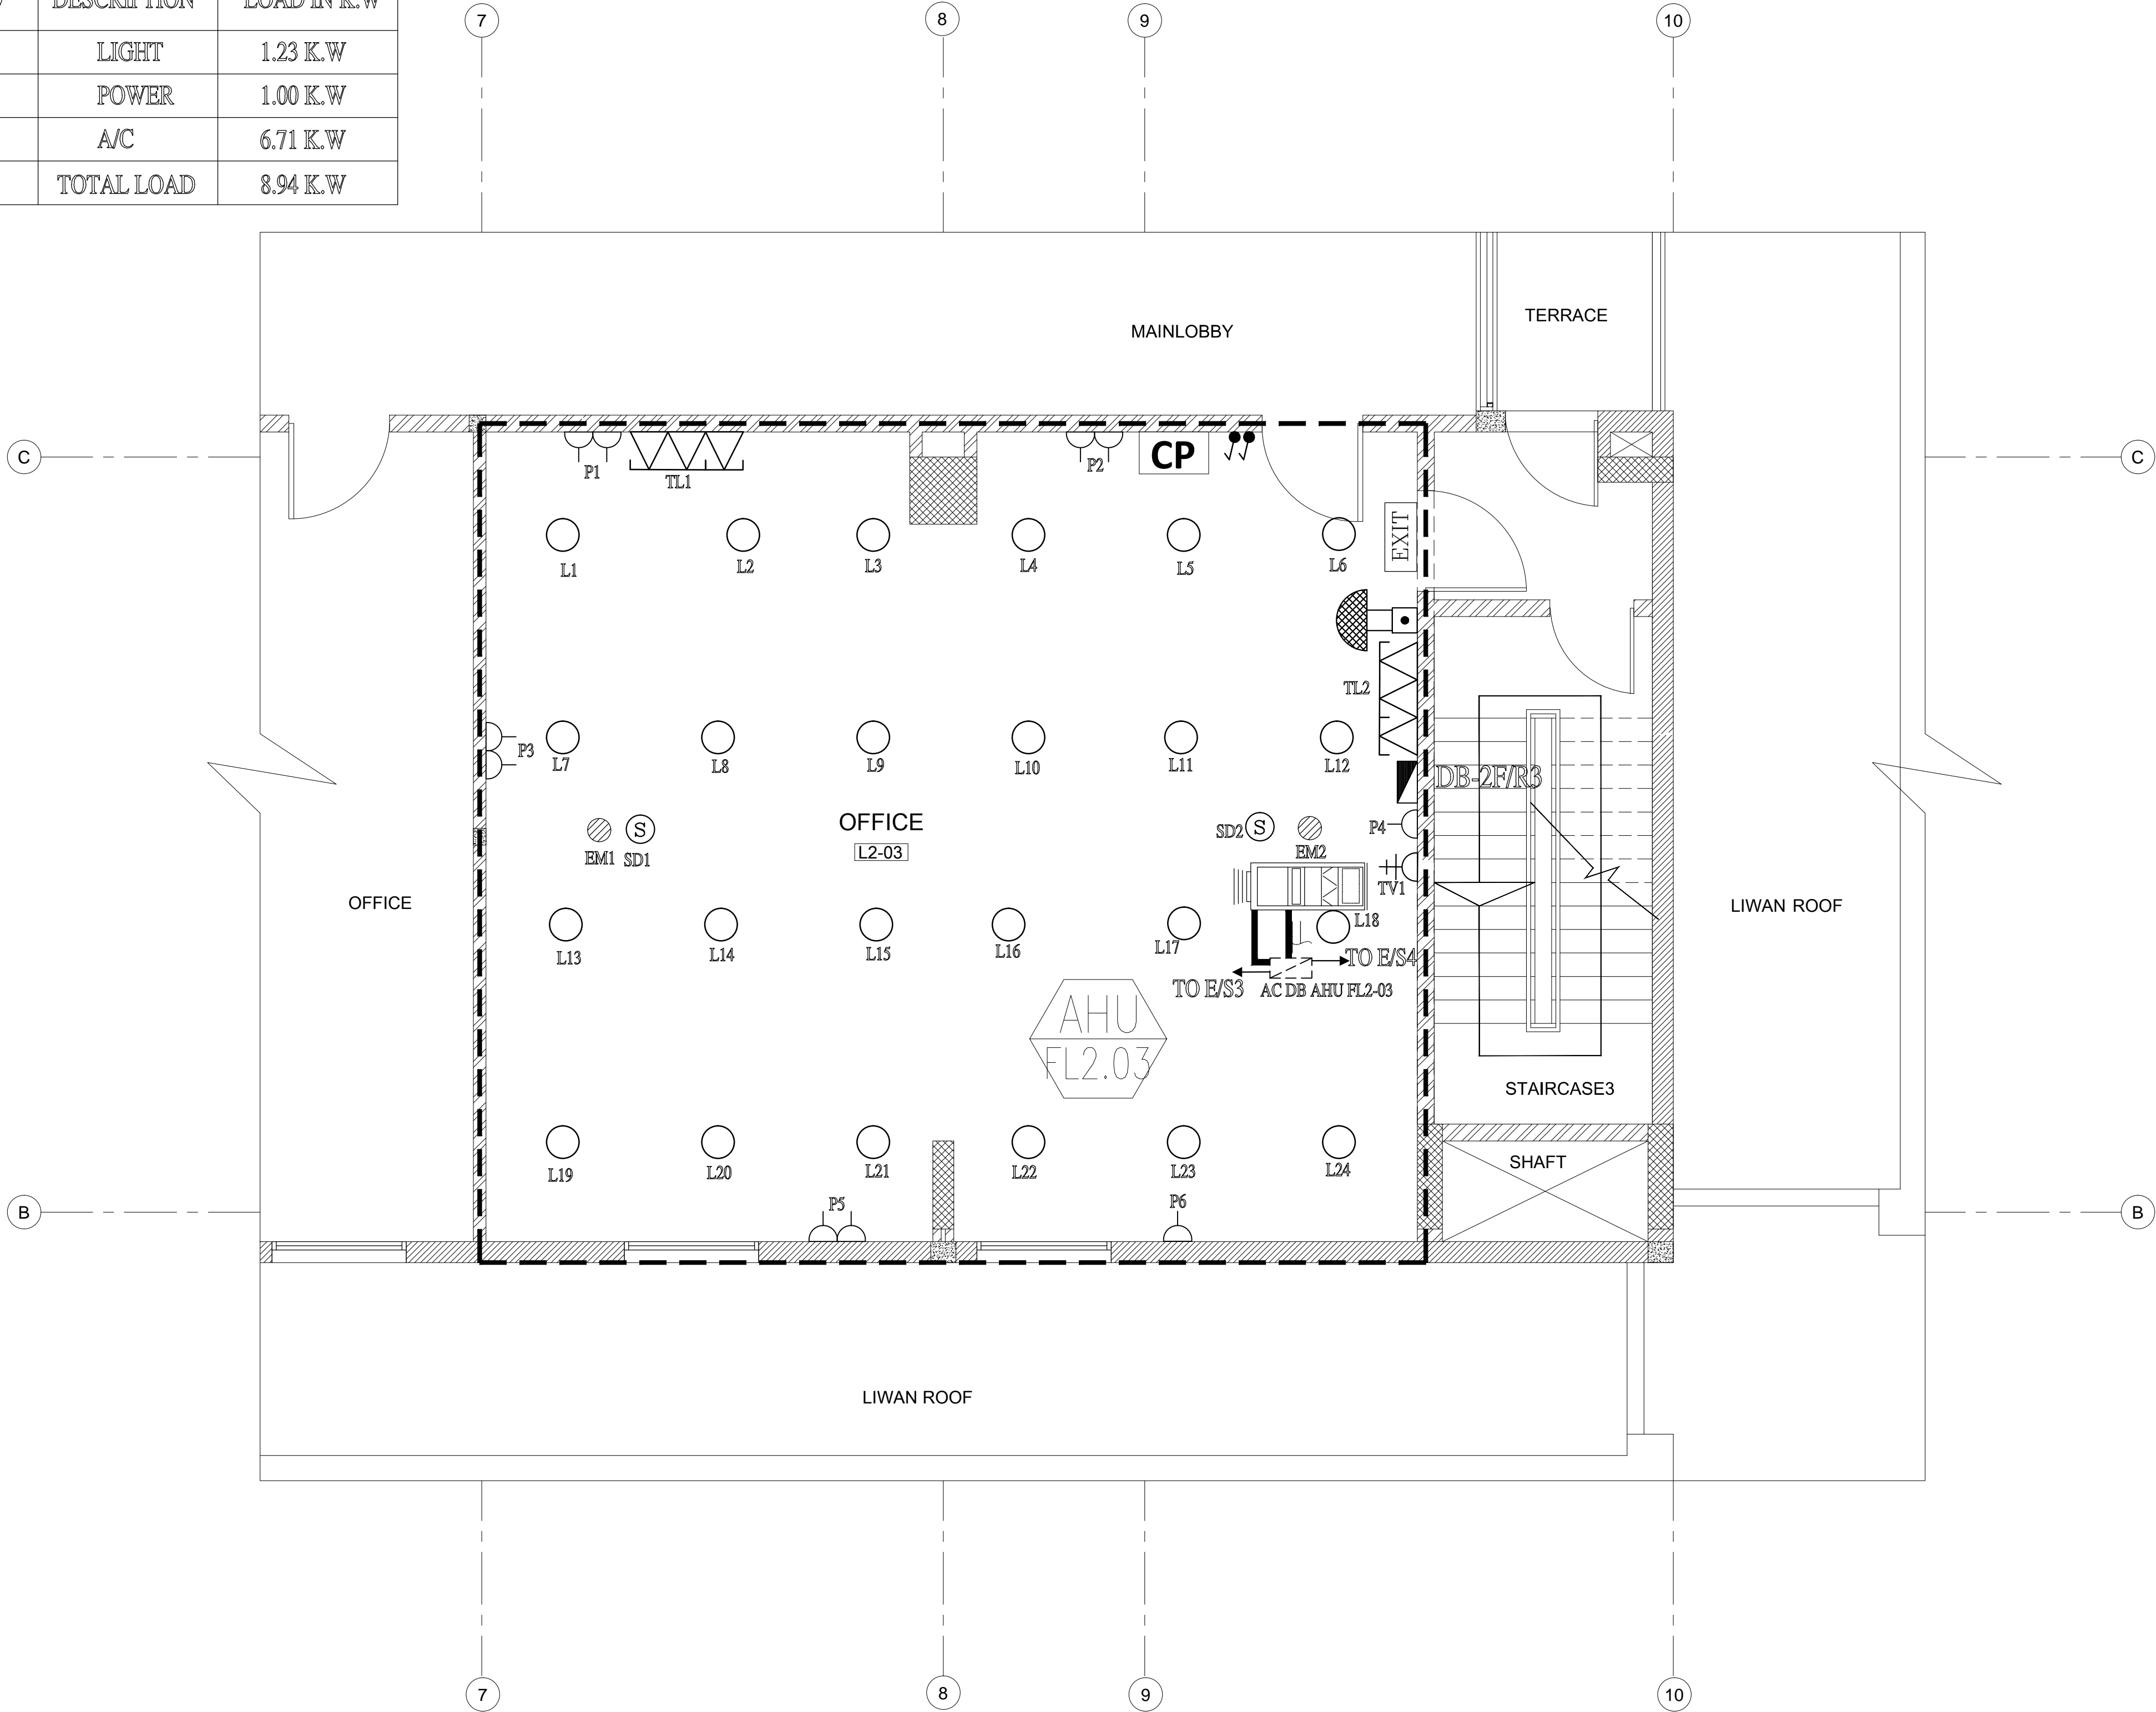


LEGEND:		
○	EM	LIGHT POINT
⊗	EX	EMERGENCY LIGHT FITTING
EXIT		EXIT SIGN BOARD FITTING
↑		ONE WAY SWITCH (LOCATED AT 140cm FROM F.F.L.)
⏏		D.B (DISTRIBUTION BOARD LOCATED AT 180cm FROM F.F.L.)
⏏		13A, 3P/N, 240V, TWIN SWITCHED SOCKET OUTLET (LOCATED AT 45 cm FROM F.F.L.)
⏏		13A, 3P/N, 240V, SINGLE SWITCHED SOCKET OUTLET (LOCATED AT 45 cm FROM F.F.L.)
⏏		AC DB (LOCATED AT ABOVE CEILING)
⏏		ADDRESSABLE SMOKE SENSOR WITH BUILT-IN ISOLATOR 10cm DIA (LOCATED AT CEILING)
⏏		ADDRESSABLE SOUNDER
⏏		ADDRESSABLE MANUAL CALL POINT 150cm FROM F.F.L.
⏏		CONSOLIDATION POINTS (8 Nos. RJ 45) (LOCATED AT HIGH LEVEL)
⏏		T.V SOCKET OUTLET (LOCATED AT 45cm FROM F.F.L.)
⏏		RJ11 TELEPHONE SOCKET OUTLET (WITH TWO BOX) (LOCATED AT 45 cm FROM F.F.L.)


GENERAL NOTES

- This drawing is indicative only (not to be used for construction)and is accurate as at the date shown on the drawing .
- This drawing is subject to change as planning , development and construction continues through until opening of the center .
- It is the responsibility of the recipient of this drawing to update themselves with any subsequent reviews , updates , additions , deletions and / or substitution .
- It is the responsibility of the investor to undertake an on-site measure to verify all dimension shown on the drawing .
- Tamdeen Shopping Centers CO K.S.C.C . (or any of it's affiliated companies) does not accept any liability of any form for the recipient's use and / or interpretation of this drawing.

NORTH DIRECTION

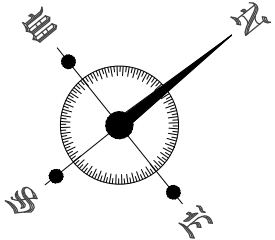

KEY PLAN

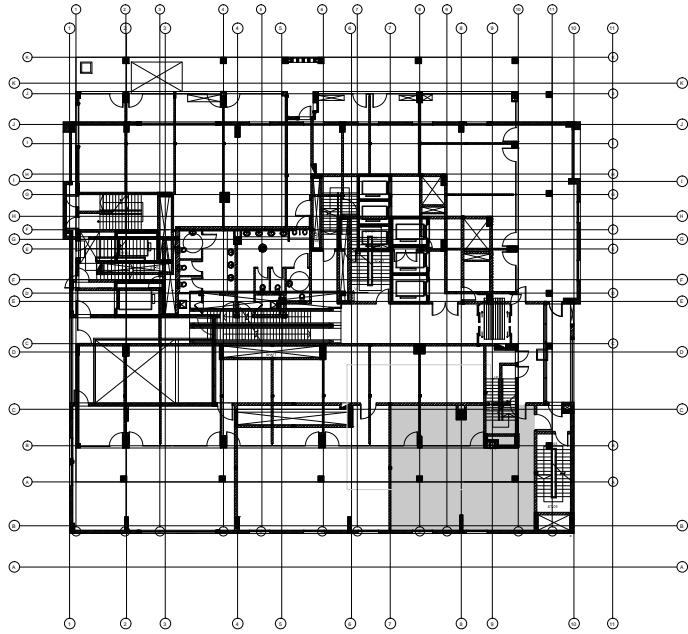

AS BUILT

OWNER : **تمدين**
TAMDEEN
SHOPPING CENTERS

MANAGE BY
gla management
GLA Property Management Co (LLC)
P O Box 230690, Safat 13151, Kuwait
+965 2536 9531 Tel
+965 2530 9531 Fax
rdd@gla.ae

CONSULTANT :
OH
OHA ENGINEERING CONSULTANT
P.O. Box 6249 HAWALLY , CODE NO.32037 - KUWAIT
PHONE: 22420508 - 22420518 FAX: 22436511
E-mail oha@ohaconsult.com

PROJECT NAME :
SAMA JAHRA

DRAWING TITLE :
SECOND FLOOR PLAN

OFFICE
UNIT NO - L2-03

DRAWN :	DESIGN :	DATE : MARCH -2017
SCALE : 1:50@A1	REVISED BY :	PAPER SIZE : A1
TRADE ELEC	REV. :	04