


S.NO	DESCRIPTION	LOAD IN K.W
1	LIGHT	1.07 K.W
2	POWER	1.00 K.W
3	A/C	6.71 K.W
	TOTAL LOAD	8.78 K.W

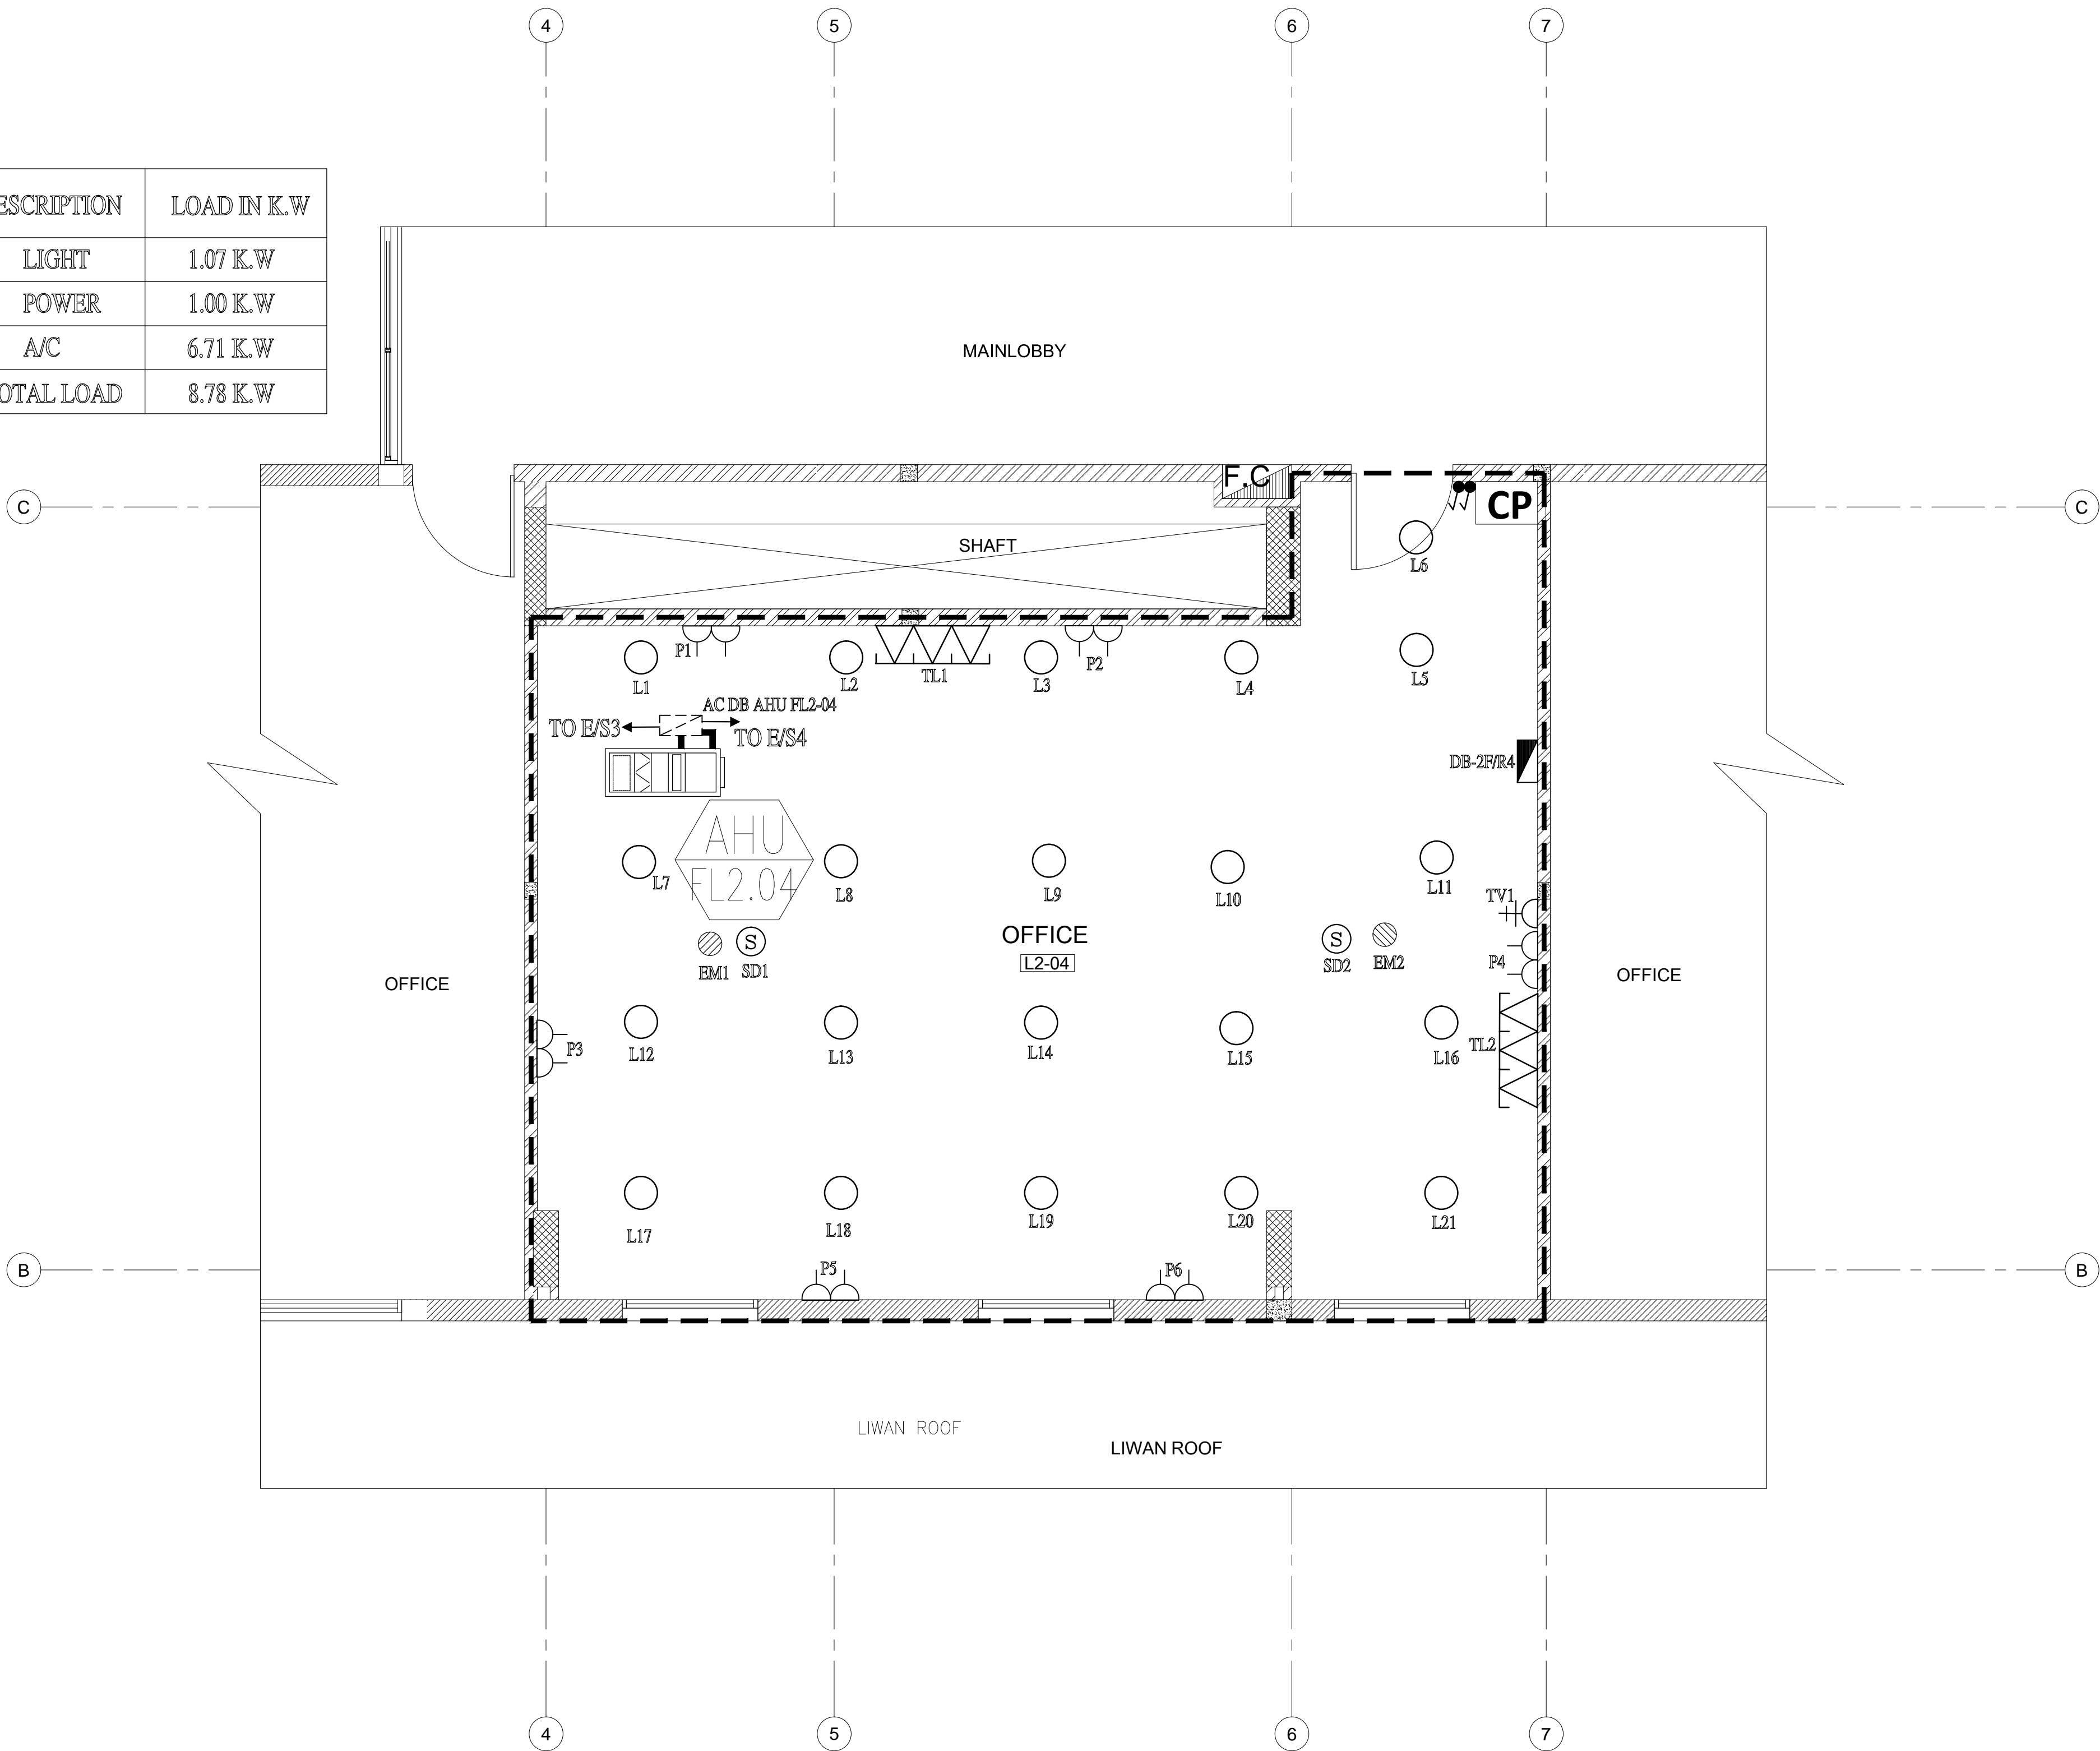


LEGEND:		
○	LIGHT POINT	
⊗	EM	EMERGENCY LIGHT FITTING
EXIT	EX	EXIT SIGN BOARD FITTING
↑		ONE WAY SWITCH (LOCATED AT 140cm FROM F.F.L.)
DB		D.B (DISTRIBUTION BOARD LOCATED AT 180cm FROM F.F.L.)
13A_3PIN_240V		13A_3PIN_240V, TWIN SWITCHED SOCKET OUTLET (LOCATED AT 45 cm FROM F.F.L.)
13A_3PIN_240V		13A_3PIN_240V, SINGLE SWITCHED SOCKET OUTLET (LOCATED AT 45 cm FROM F.F.L.)
AC DB		A/C DB (LOCATED AT ABOVE CEILING)
⊗		ADDRESSABLE SMOKE SENSOR WITH BUILT-IN ISOLATOR 10cm DIA (LOCATED AT CEILING)
CP		CONSOLIDATION POINTS (8 Nos. RJ 45) (LOCATED AT HIGH LEVEL)
TV		T.V SOCKET OUTLET (LOCATED AT 45cm FROM F.F.L.)
RJ11		RJ11 TELEPHONE SOCKET OUTLET (WITH TWO BOX) (LOCATED AT 45 cm FROM F.F.L.)


## GENERAL NOTES

- This drawing is indicative only (not to be used for construction )and is accurate as at the date shown on the drawing .
- This drawing is subject to change as planning , development and construction continues through until opening of the center .
- It is the responsibility of the recipient of this drawing to update themselves with any subsequent reviews , updates , additions , deletions and / or substitution .
- It is the responsibility of the investor to undertake an on-site measure to verify all dimension shown on the drawing .
- Tamdeen Shopping Centers CO K.S.C.C . ( or any of it's affiliated companies ) does not accept any liability of any form for the recipient's use and / or interpretation of this drawing.

## NORTH DIRECTION

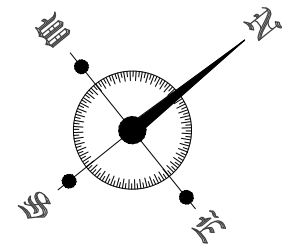

## KEY PLAN

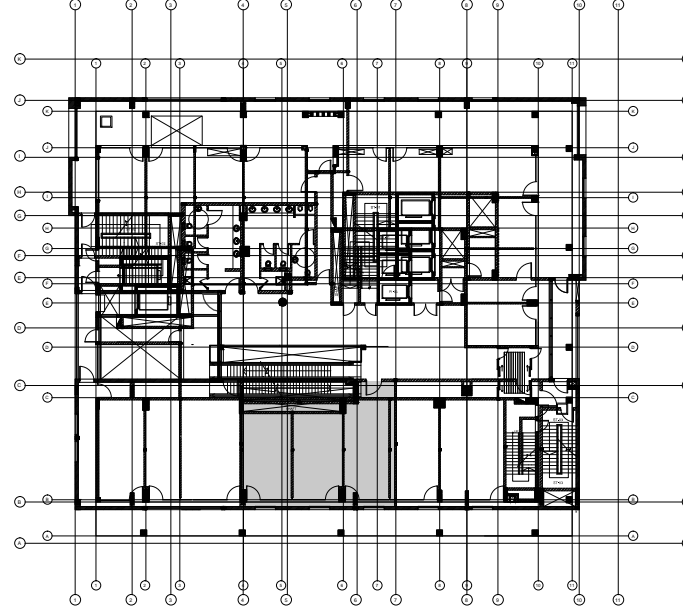

## AS BUILT

OWNER : **تمددين**  
**TAMDEEN**  
SHOPPING CENTERS

MANAGE BY  
**gla** management  
GLA Property Management Co (LLC)  
P O Box 230960, Safat 13151, Kuwait  
+965 2536 9531 Tel  
+965 2530 9531 Fax  
rdd@gla.ae

CONSULTANT :  
**OH**  
OHA ENGINEERING CONSULTANT  
P.O. Box 6249 HAWALLI , CODE NO.32037 - KUWAIT  
PHONE: 22420508 - 22420518 FAX: 22436511  
E-mail oha@ohaconsult.com

PROJECT NAME :  
**SAMA JAHRA**

DRAWING TITLE :  
**SECOND FLOOR PLAN**

OFFICE  
UNIT NO - L2-04

DRAWN :	DESIGN :	DATE : <b>MARCH -2017</b>
SCALE : <b>1:50@A1</b>	REVISED BY :	PAPER SIZE : <b>A1</b>
TRADE <b>ELEC</b>		REV. : <b>04</b>