



## GENERAL NOTES

- This drawing is indicative only (not to be used for construction) and is accurate as at the date shown on the drawing.
- This drawing is subject to change as planning, development and construction continues through until opening of the center.
- It is the responsibility of the recipient of this drawing to update themselves with any subsequent reviews, updates, additions, deletions and / or substitution.
- It is the responsibility of the investor to undertake an on-site measure to verify all dimension shown on the drawing.
- Tamdeen Shopping Centers CO K.S.C.C. (or any of its affiliated companies) does not accept any liability of any form for the recipient's use and / or interpretation of this drawing.

## NORTH DIRECTION

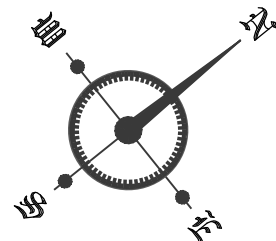

## KEY PLAN

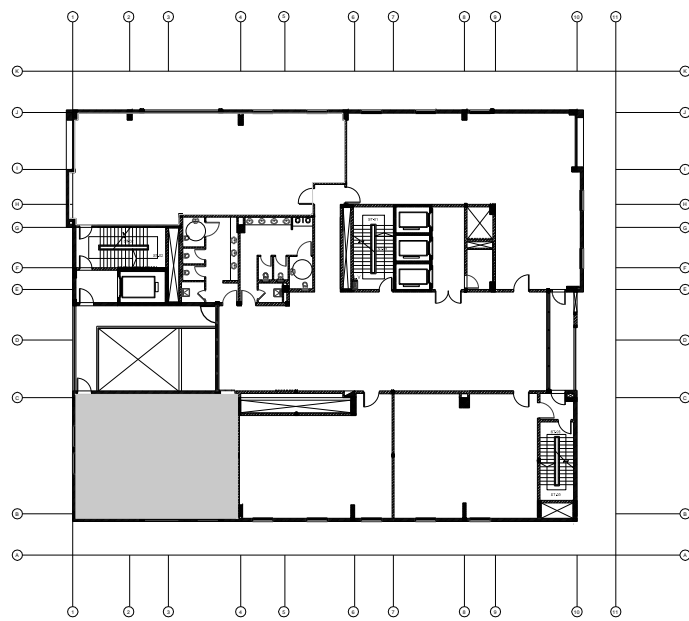

## AS BUILT

OWNER : **تمدين**  
**TAMDEEN**  
SHOPPING CENTERS

MANAGE BY  
**gla** management  
GLA Property Management Co (LLC)  
P.O. Box 29060, Safat 13151, Kuwait  
+965 2536 9531 Tel  
+965 2530 9531 Fax  
rdd@gla.ae

CONSULTANT :  
**OH**  
مكتب عومة الاستشارات الهندسية  
OHA ENGINEERING CONSULTANT  
P.O. Box 6049 HAWALLI, CODE NO.32037 - KUWAIT  
PHONE: 22420508 - 22420518 FAX: 22436511  
E-mail oha@ohaconsult.com

PROJECT NAME :  
**SAMA JAHRA**

DRAWING TITLE :  
**SECOND FLOOR PLAN**

OFFICE UNIT NO - L2-05 DRAINAGE SYSTEM		
DRAWN :	DESIGN :	DATE : MAR-2017
SCALE : 1:50@A1	REVISED BY :	PAPER SIZE : A1
TRADE MECH DR-01	REV. : 04	