



GENERAL NOTES

- This drawing is indicative only (not to be used for construction) and is accurate as at the date shown on the drawing .
- This drawing is subject to change as planning ,development , and construction continues through until opening of the center .
- It is the responsibility of the recipient of this drawing to update themselves with any subsequent reviews , updates , additions , deletions and / or substitution .
- It is the responsibility of the investor to undertake an on-site measure to verify all dimension shown on the drawing .
- Tamdeen Shopping Centers CO K.S.C.C . (or any of it's affiliated companies) does not accept any liability of any form for the recipient's use and / or interpretation of this drawing.

NORTH DIRECTION

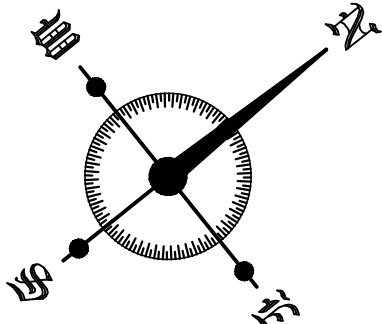


KEY PLAN

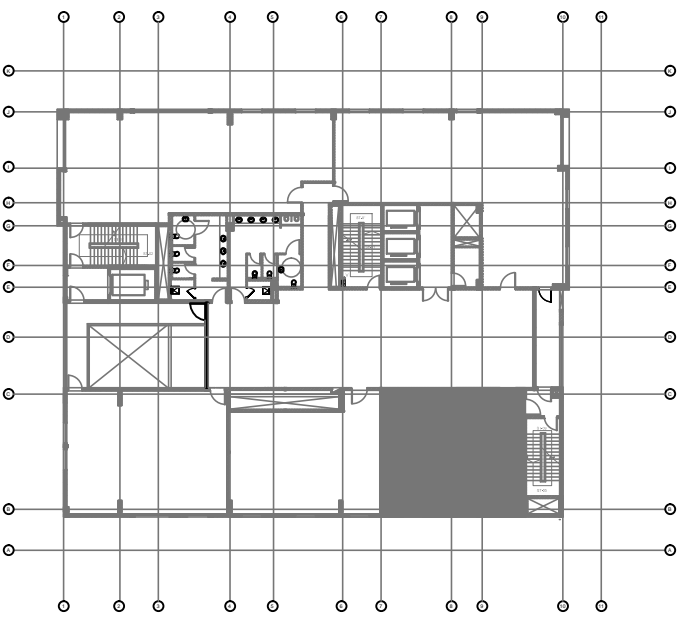

AS BUILT

OWNER : 

MANAGE BY  GLA Property Management Co (LLC)
P O Box 29060, Safat 13151, Kuwait
+965 2536 9531 Tel
+965 2530 9531 Fax
rdd@gl.ae

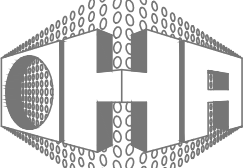
CONSULTANT :  **مكتب مهندسين ا.م.ع.م.ا**
OHA ENGINEERING CONSULTANT
P. O. Box 6248 HAWALLI, CODE NO.32037 - KUWAIT
PHONE: 22420508 - 22420518 FAX: 22436511
E-mail oha@ohaconsult.com

PROJECT NAME :
SAMA JAHRA

DRAWING TITLE :
SECOND FLOOR PLAN

OFFICE
UNIT NO - L2-03

DRAWN :	DESIGN :	DATE : MAR-2017
SCALE : 1:50@A1	REVISED BY :	PAPER SIZE : A1
TRADE HVAC		REV. : 04

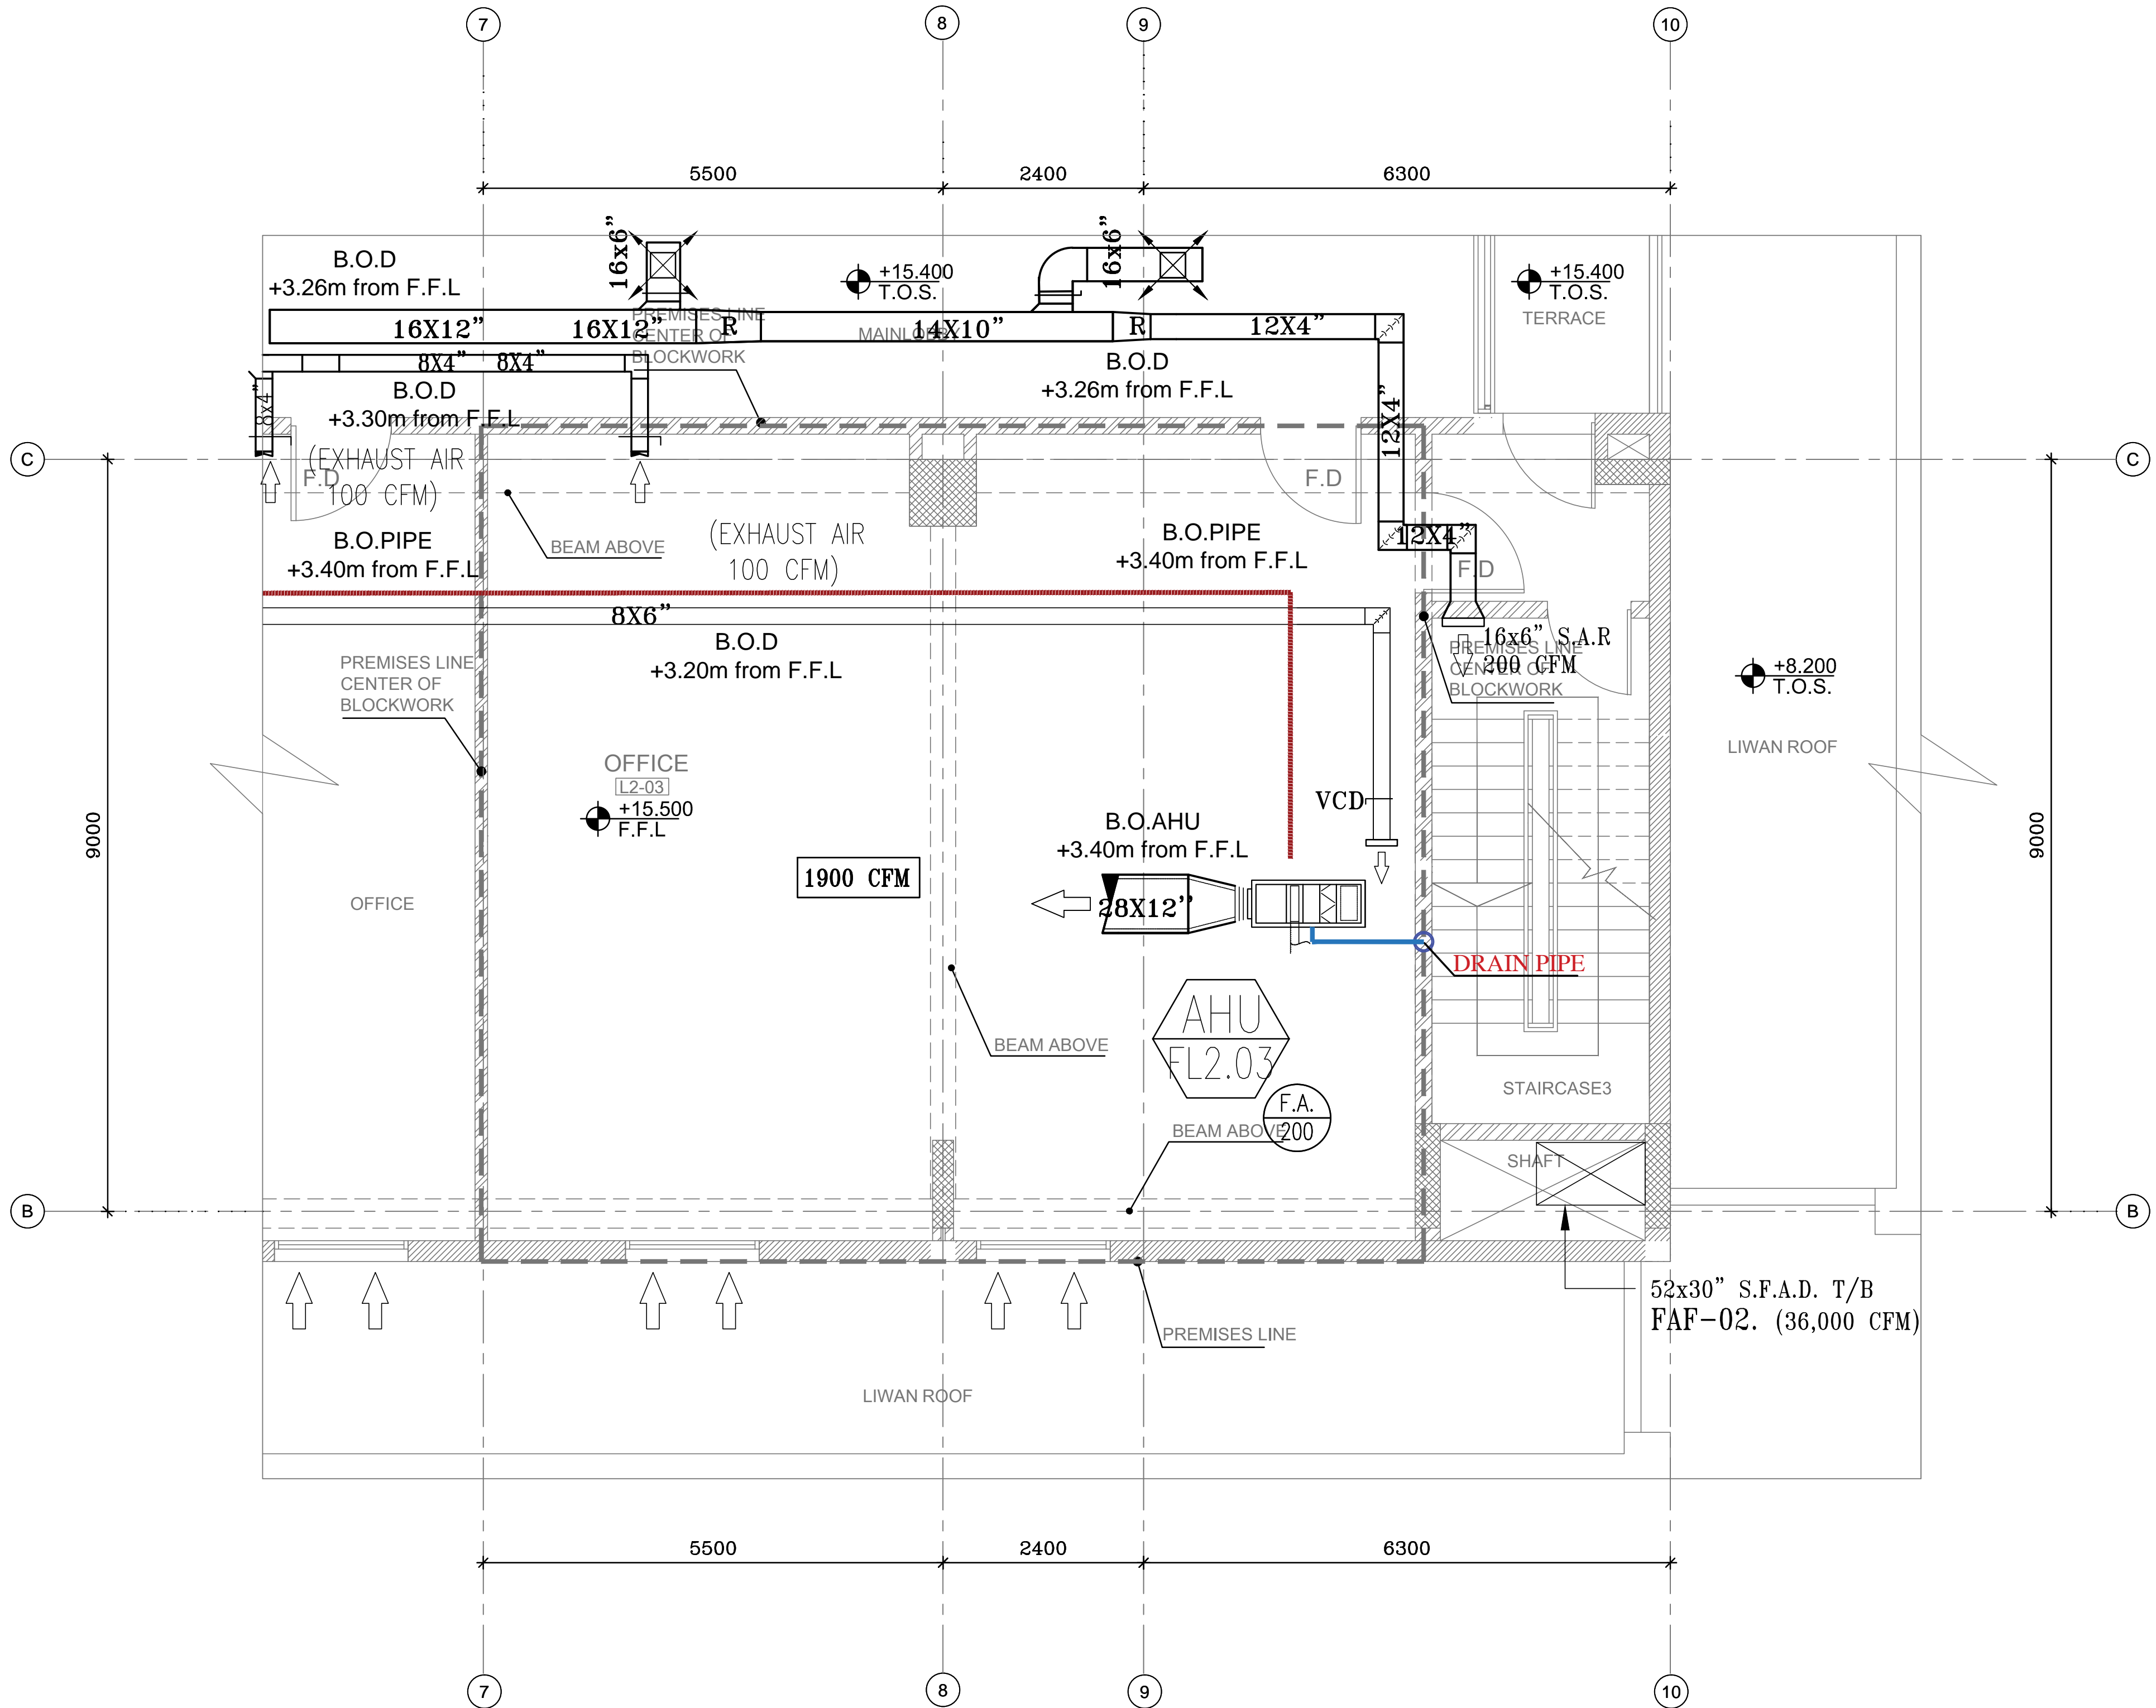

Unit No	Btu/Hr	CFM	Servies Location	Model	BTU/Hr	CFM	KW	CU Length	CU Width	CU Height	CU Weight	FCU Length	FCU Width	FCU Height	FCU Weight	COMP. KW	COND. KW	EVAP. KW
FL2 - 03	56616	1900	OFFICES	38ARZ007/FB4ASSF060	56,616	1900	6.71	1504	1157	948	154	1357	560	537	80	5.78	0.23	0.7