



GENERAL NOTES

- This drawing is indicative only (not to be used for construction) and is accurate as at the date shown on the drawing .
- This drawing is subject to change as planning ,development and construction continues through until opening of the center .
- It is the responsibility of the recipient of this drawing to update themselves with any subsequent reviews , updates , additions , deletions and / or substitution .
- It is the responsibility of the investor to undertake an on-site measure to verify all dimension shown on the drawing .
- Tamdeen Shopping Centers CO K.S.C.C . (or any of it's affiliated companies) does not accept any liability of any form for the recipient's use and / or interpretation of this drawing .

NORTH DIRECTION

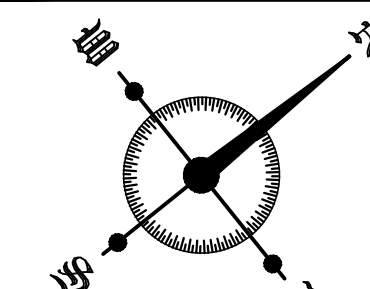

KEY PLAN

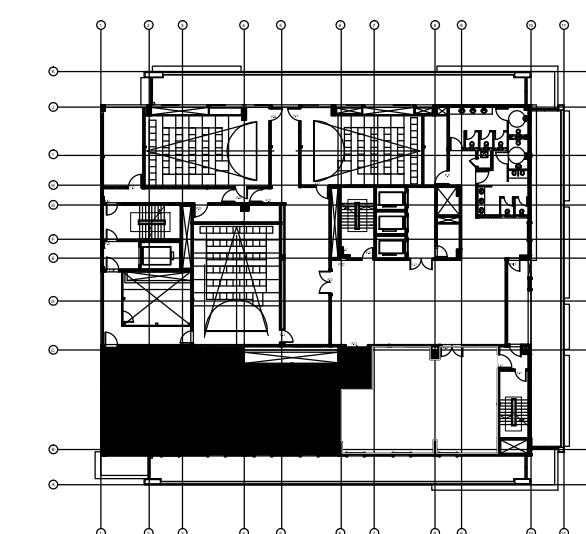

AS BUILT

OWNER :


تمدين
TAMDEEN
SHOPPING CENTERS

MANAGE BY

gla
management

GLA Property Management Co (LLC)
P O Box 29060, Safat 13151, Kuwait
+965 2536 9531 Tel
+965 2530 9531 Fax
rdd@gla.ae

CONSULTANT :

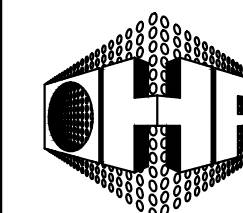

مهندسة ا.م.ع.ا
OHA ENGINEERING CONSULTANT
P.O. Box 6246 - HAWALLI, CODE NO. 32037 - KUWAIT
PHONE: 22420508 - 22420518 FAX: 22436511
E-mail oha@ohaconsult.com

PROJECT NAME :


SAMA JAHRA

DRAWING TITLE :

FIRST FLOOR PLAN

INSTITUTE/ENTERTAINMENT
UNIT NO - L1-02

DRAWN :	DESIGN :	DATE : MAR-2017
SCALE : 1:50@A1	REVISED BY :	PAPER SIZE : A1
TRADE HVAC	REV. :	05

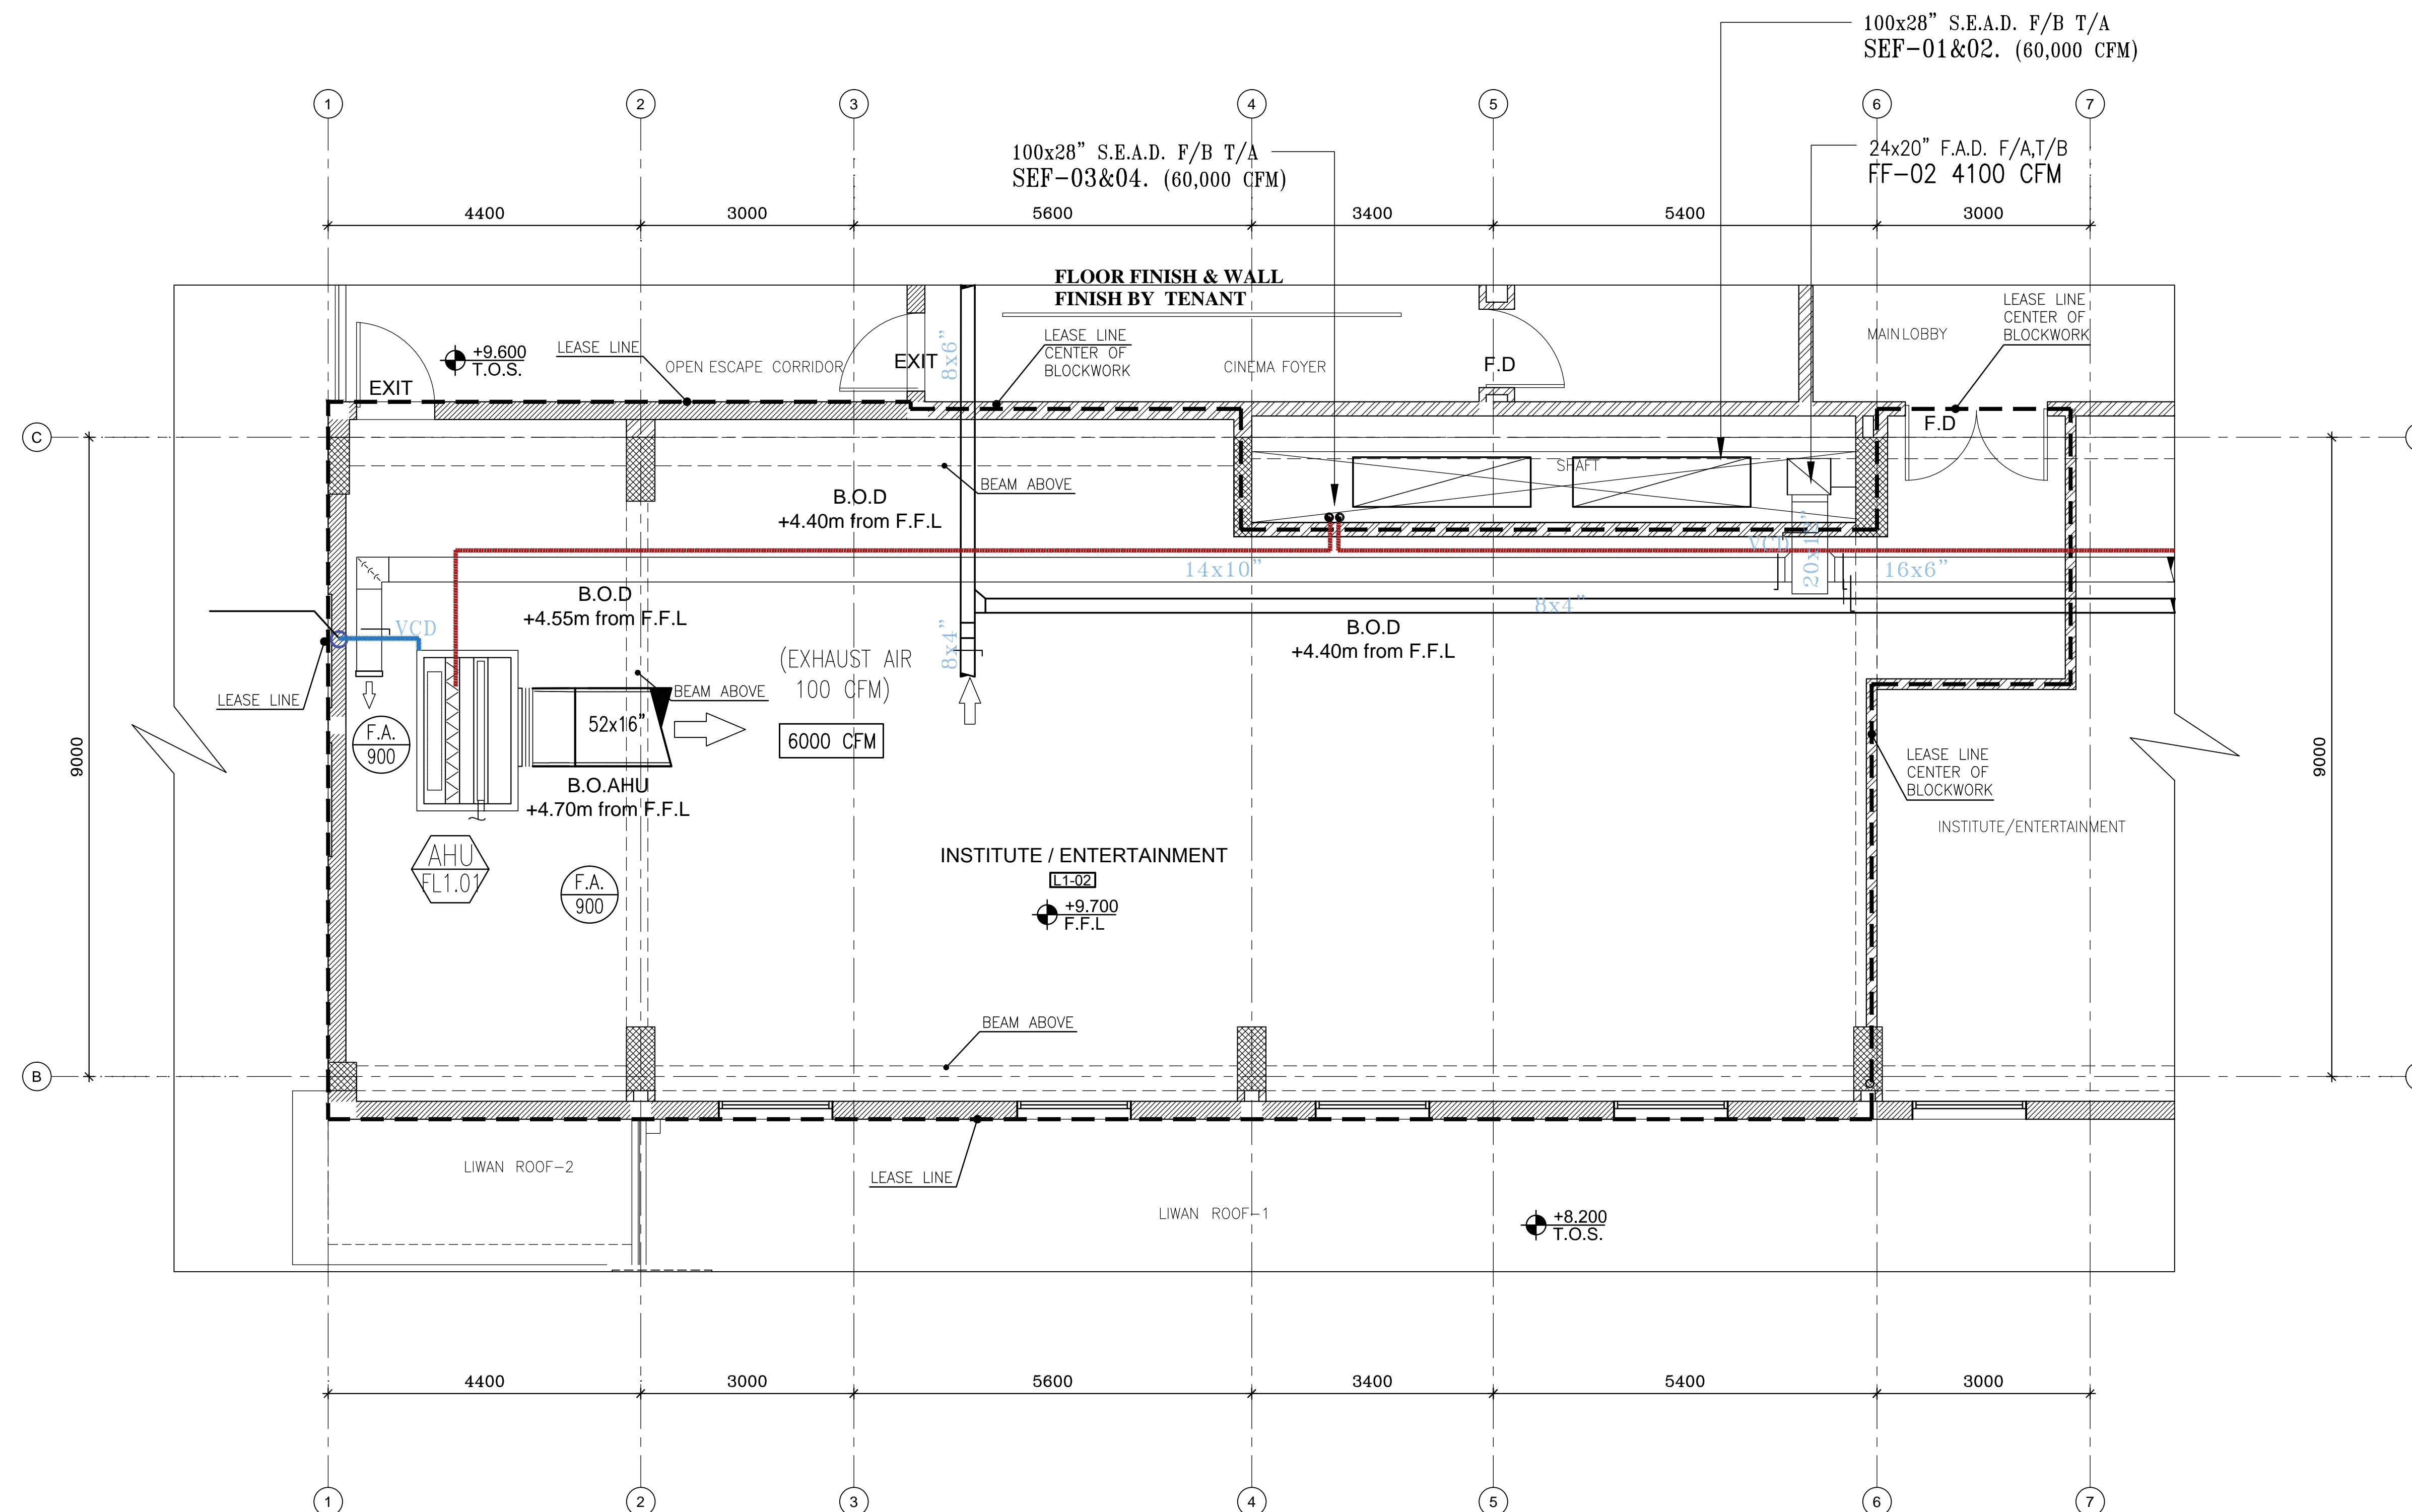

Unit No	Btu/Hr	CFM	serving room	Model	BTU/Hr	CFM	KW	CU Length	CU Width	CU Height	CU Weight	FCU Length	FCU Width	FCU Height	FCU Weight	COMP. KW	COND. KW	EVAP. KW
FL1 - 01	170500	6000	ENTERTAINMENT	38ARD016/40RM016	170,500	6000	19.23	1844	1124	1058	386	1424	2260	716	371	15.6	0.93	2.7