


S.NO	DESCRIPTION	LOAD IN K.W
1	LIGHT	2.14 K.W
2	POWER	1.00 K.W
3	A/C	19.23 K.W
TOTAL LOAD		22.37 K.W


## GENERAL NOTES

- This drawing is indicative only (not to be used for construction) and is accurate as at the date shown on the drawing.
- This drawing is subject to change as planning, development, and construction continues through until opening of the center.
- It is the responsibility of the recipient of this drawing to update themselves with any subsequent reviews, updates, additions, deletions and / or substitution.
- It is the responsibility of the investor to undertake an on-site measure to verify all dimension shown on the drawing.
- Tamdeen Shopping Centers CO K.S.C.C. (or any of its affiliated companies) does not accept any liability of any form for the recipient's use and / or interpretation of this drawing.

## NORTH DIRECTION

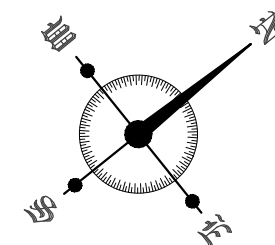

## KEY PLAN

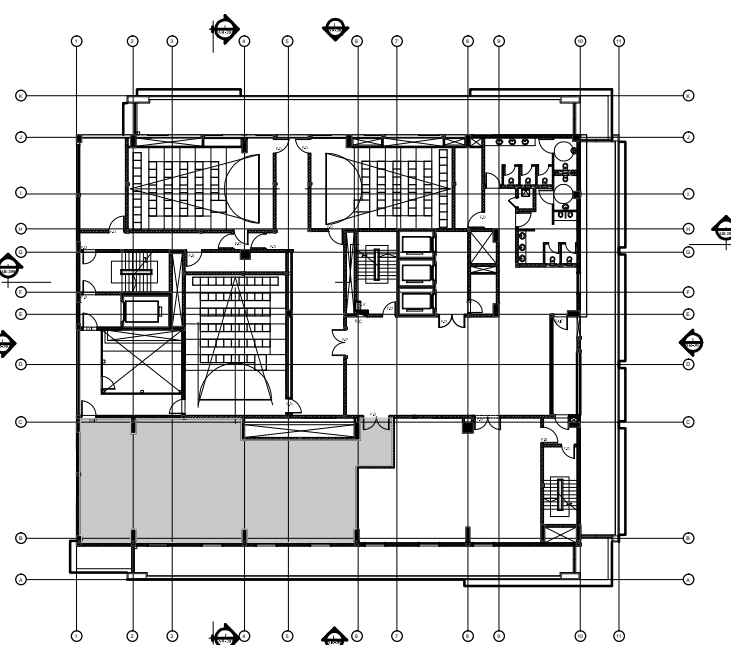

## AS BUILT

OWNER : **تمدين**  
**TAMDEEN**  
SHOPPING CENTERS

MANAGE BY  
**gla** management  
GLA Property Management Co (LLC)  
P.O. Box 23060, Safat 13151, Kuwait  
+965 2536 9531 Tel  
+965 2530 9531 Fax  
rdd@gla.ae

CONSULTANT :  
**OHA ENGINEERING CONSULTANT**  
P.O. Box 6249 HAWALLI, CODE NO.32037 - KUWAIT  
PHONE: 22420508 - 22420518 FAX: 22436511  
E-mail oha@ohaconsult.com

PROJECT NAME :  
**SAMA JAHRA**

DRAWING TITLE :  
**FIRST FLOOR PLAN**

**INSTITUTE/ENTERTAINMENT**  
**UNIT NO - L1-02**

DRAWN :	DESIGN :	DATE : <b>MAR-2017</b>
SCALE : <b>1:50@A1</b>	REVISED BY :	PAPER SIZE : <b>A1</b>
TRADE <b>ELEC</b>	REV. :	<b>04</b>

- LEGEND:
- LIGHT POINT
  - EM EMERGENCY LIGHT FITTING
  - EX EXIT SIGN BOARD
  - ONE WAY SWITCH (LOCATED AT 140cm FROM F.F.L.)
  - D.B (DISTRIBUTION BOARD LOCATED AT 180cm FROM F.F.L.)
  - 13A, 3PIN, 240V, TWIN SWITCHED SOCKET OUTLET (LOCATED AT 45 cm FROM F.F.L.)
  - 13A, 3PIN, 240V, SINGLE SWITCHED SOCKET OUTLET (LOCATED AT 45 cm FROM F.F.L.)
  - A/C DB (LOCATED AT ABOVE CEILING)
  - ADDRESSABLE SMOKE SENSOR WITH BUILT-IN ISOLATOR 10cm DIA (LOCATED AT CEILING)
  - ADDRESSABLE MANUAL CALL POINT 150cm FROM F.F.L.
  - ADDRESSABLE SOUNDER
  - CONSOLIDATION POINTS (8 Nos. RJ 45) (LOCATED AT HIGH LEVEL)
  - T.V SOCKET OUTLET (LOCATED AT 45cm FROM F.F.L.)
  - RJ11 TELEPHONE SOCKET OUTLET (WITH TWO BOX) (LOCATED AT 45 cm FROM F.F.L.)