



SECTION A-A

SCALE 1:50

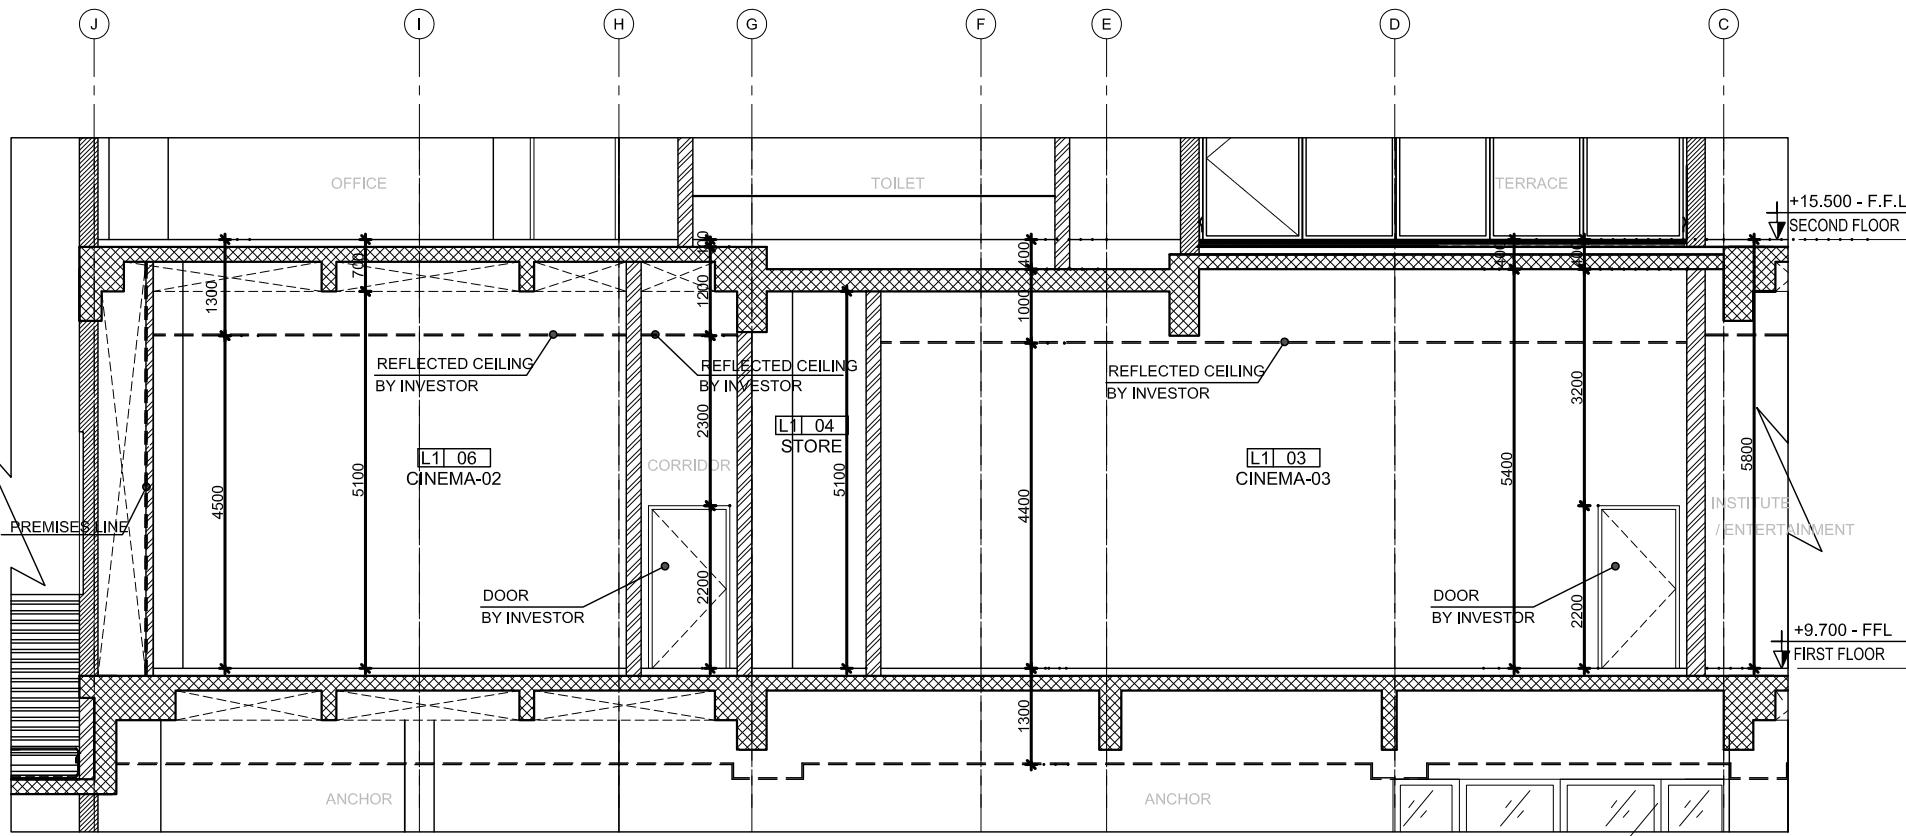

SECTION B-B

SCALE 1:50

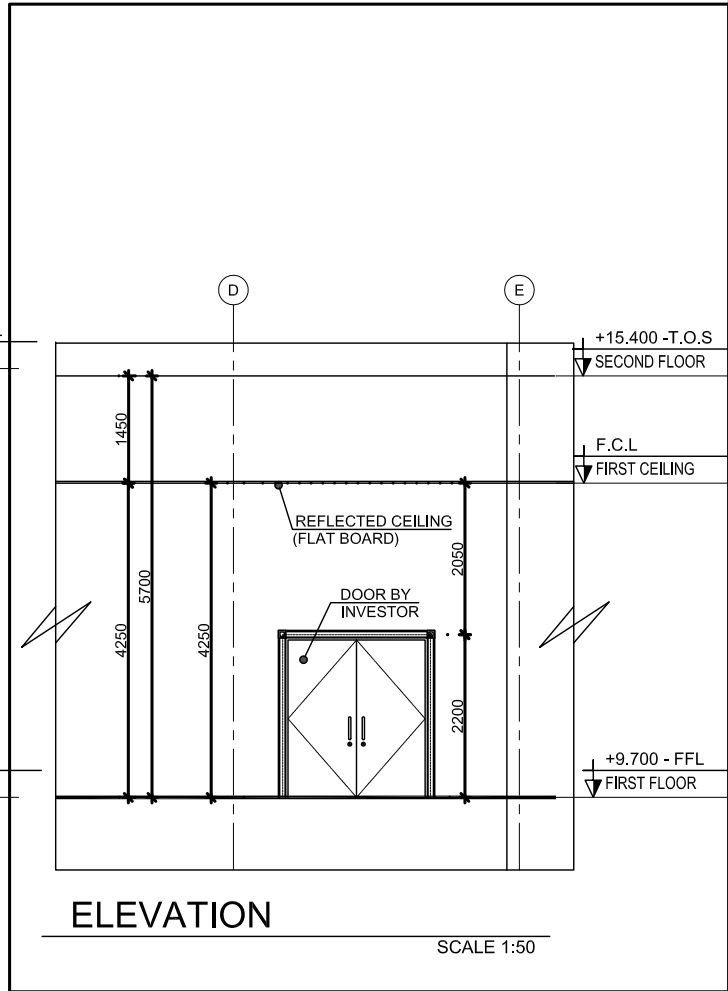

ELEVATION

SCALE 1:50


## GENERAL NOTES

- This drawing is indicative only (not to be used for construction) and is accurate as at the date shown on the drawing.
- This drawing is subject to change as planning, development and construction continues through until opening of the center.
- It is the responsibility of the recipient of this drawing to update themselves with any subsequent reviews, updates, additions, deletions and / or substitution.
- It is the responsibility of the investor to undertake an on-site measure to verify all dimension shown on the drawing.
- Tamdeen Shopping Centers CO K.S.C.C. (or any of its affiliated companies) does not accept any liability of any form for the recipient's use and / or interpretation of this drawing.

## NORTH DIRECTION



## KEY PLAN

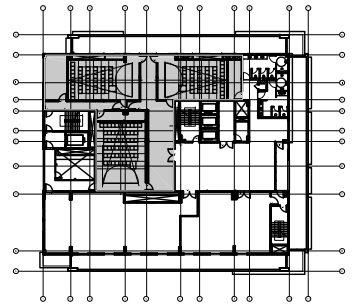

## AS BUILT

OWNER :



MANAGE BY



GLA Property Management Co (LLC)  
P O Box 29060, Safat 13151, Kuwait  
+965 2536 9531 Tel  
+965 2530 9531 Fax  
rdd@gla.ae

CONSULTANT :



مهندسون معماريون  
OHA ENGINEERING CONSULTANT  
P.O. Box 6249 HAWALLI, CODE NO.32037 - KUWAIT  
PHONE: 22420508 - 22420518 FAX: 22436511  
E-mail: oha@ohaconsult.com

PROJECT NAME :

SAMA JAHRA

DRAWING TITLE :

FIRST FLOOR PLAN

CINEMA  
UNIT NO - L1-03,4,5,6,7,8

DRAWN :	DESIGN :	DATE : MAR-2017
SCALE : 1:50@A1	REVISED BY :	PAPER SIZE : A1
TRADE ARCH-SEC/ELEV-02	REV. :	04