


Unit No	Btu/Hr	CFM	serving room	Model	BTU/Hr	CFM	KW	CU Length	CU Width	CU Height	CU Weight	FCU Length	FCU Width	FCU Height	FCU Weight	COMP. KW	COND. KW	EVAP. KW
FL1 - 02	121500	5000	ENTERTAINMENT	38ARD014/40RM014	121,500	5000	15.63	1844	1124	1058	357	1524	2260	716	364	12	0.93	2.7


## GENERAL NOTES

- This drawing is indicative only ( not to be used for construction ) and is accurate as at the date shown on the drawing .
- This drawing is subject to change as planning ,development and construction continues through until opening of the center .
- It is the responsibility of the recipient of this drawing to update themselves with any subsequent reviews , updates , additions , deletions and / or substitution .
- It is the responsibility of the investor to undertake an on-site measure to verify all dimension shown on the drawing .
- Tamdeen Shopping Centers CO K.S.C.C . ( or any of it's affiliated companies ) does not accept any liability of any form for the recipient's use and / or interpretation of this drawing.

## NORTH DIRECTION

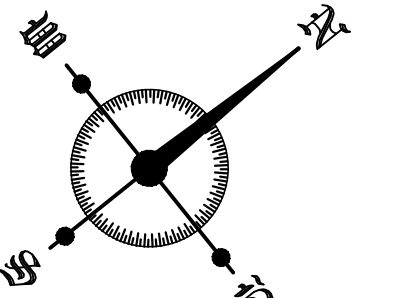

## KEY PLAN

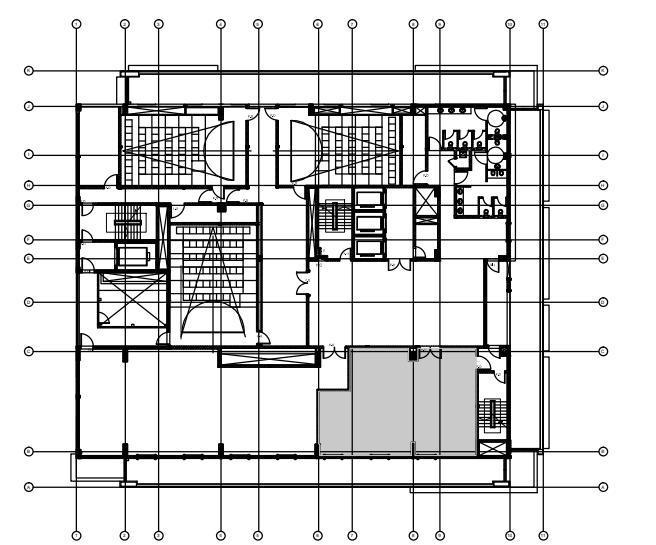

## AS BUILT

OWNER :


تمدين  
TAMDEEN  
SHOPPING CENTERS

MANAGE BY

gla  
management

GIA Property Management Co (LLC)  
P O Box 23060, Safat 13151, Kuwait  
+965 2536 9531 Tel  
+965 2530 9531 Fax  
rdd@gia.ae

CONSULTANT :

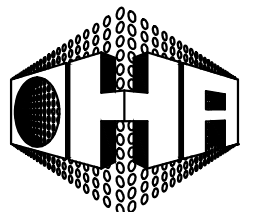

مهندسة ا.م.الهندسة  
OHA ENGINEERING CONSULTANT  
P.O. Box 6249 HAWALLI , CODE NO.32037 - KUWAIT  
PHONE: 22420508 - 22420518 FAX: 22436511  
E-mail oha@ohaconsult.com

PROJECT NAME :

SAMA JAHRA

DRAWING TITLE :

FIRST FLOOR PLAN

INSTITUTE/ENTERTAINMENT  
UNIT NO - L1-01

DRAWN :	DESIGN :	DATE :
SCALE :	REVISED BY :	PAPER SIZE :
1:50@A1		A1
TRADE HVAC		REV. : 05