



GENERAL NOTES

- This drawing is indicative only (not to be used for construction) and is accurate as at the date shown on the drawing.
- This drawing is subject to change as planning, development, and construction continues through until opening of the center.
- It is the responsibility of the recipient of this drawing to update themselves with any subsequent reviews, updates, additions, deletions and / or substitution.
- It is the responsibility of the investor to undertake an on-site measure to verify all dimension shown on the drawing.
- Tamdeen Shopping Centers CO K.S.C.C. (or any of its affiliated companies) does not accept any liability of any form for the recipient's use and / or interpretation of this drawing.

NORTH DIRECTION

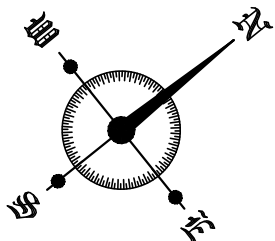

KEY PLAN

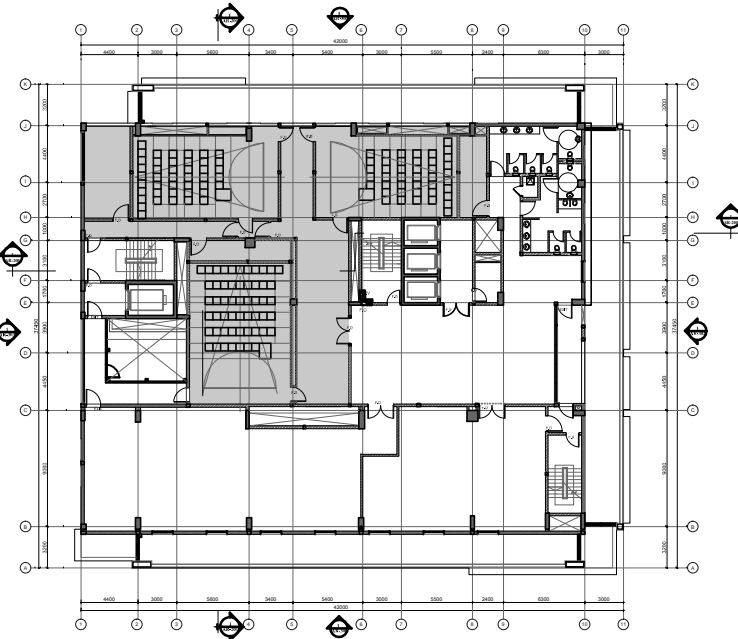

AS BUILT

OWNER :


تمدين
TAMDEEN
SHOPPING CENTERS

MANAGE BY

gla
management

GLA Property Management Co (LLC)
P.O. Box 29060, Safat 13151, Kuwait
+965 2536 9531 Tel
+965 2530 9531 Fax
rdd@gla.ae

CONSULTANT :

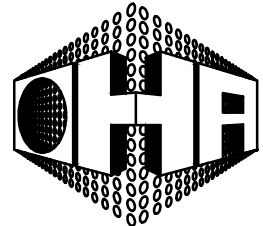

مكتب عومة الاستشارات الهندسية
OHA ENGINEERING CONSULTANT
P.O. Box 6049, HAWALLI, CODE NO.32037 - KUWAIT
PHONE: 22420508 - 22420518 FAX: 22436511
E-mail: oha@ohaconsult.com

PROJECT NAME :

SAMA JAHRA

DRAWING TITLE :

FIRST FLOOR PLAN

CINEMA
UNIT NO - L1-03,4,5,6,7,8

FIRE PROTECTION SYSTEM

DRAWN :	DESIGN :	DATE : MAR-2017
SCALE : 1:50@A1	REVISED BY :	PAPER SIZE : A1
TRADE MECH FP-01	REV. :	04