


S.NO	DESCRIPTION	LOAD IN K.W
1	LIGHT	1.23 K.W
2	POWER	1.00 K.W
3	A/C	8.75 K.W
	TOTAL LOAD	10.98 K.W

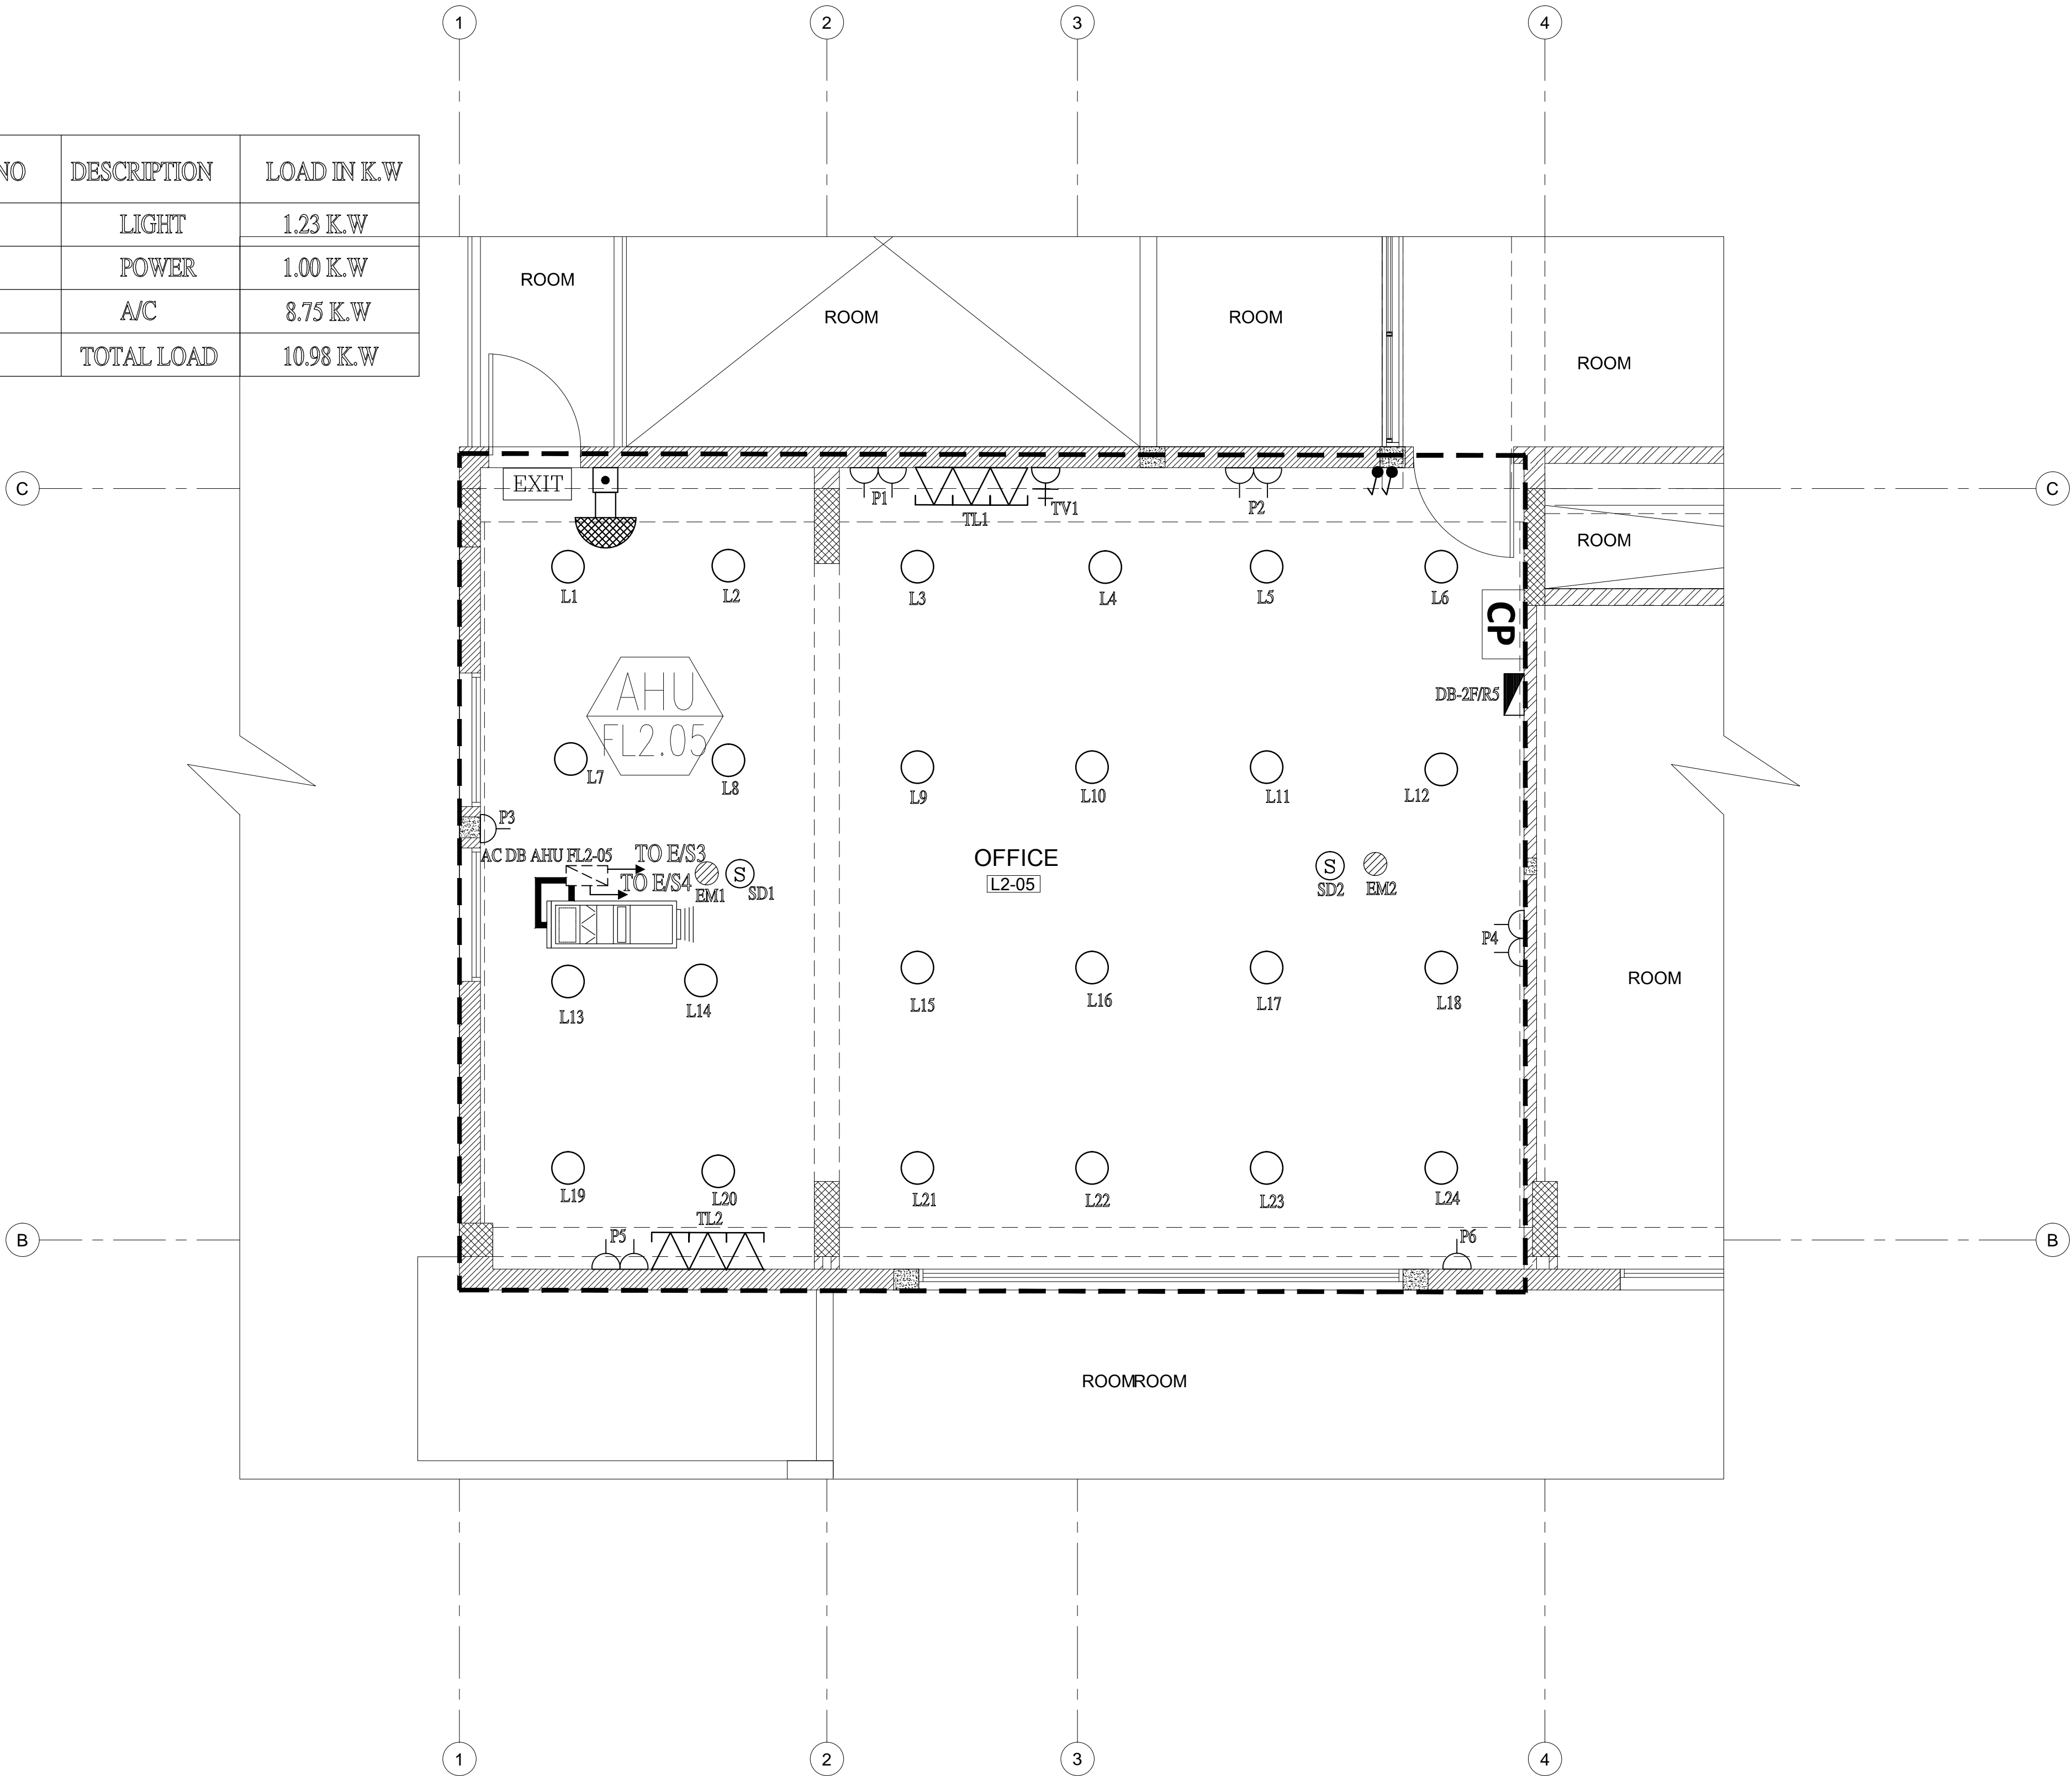


LEGEND:	
○	LIGHT POINT
⊗	EM EMERGENCY LIGHT FITTING
EXIT	EXIT SIGN BOARD FITTING
↑	ONE WAY SWITCH [LOCATED AT 140cm FROM F.F.L]
⏏	D.B [DISTRIBUTION BOARD LOCATED AT 180cm FROM F.F.L]
⏏	13A, 3P/N, 240V, TWIN SWITCHED SOCKET OUTLET [LOCATED AT 45 cm FROM F.F.L]
⏏	13A, 3P/N, 240V, SINGLE SWITCHED SOCKET OUTLET [LOCATED AT 45 cm FROM F.F.L]
⏏	A/C DB [LOCATED AT ABOVE CEILING]
⏏	ADDRESSABLE SMOKE SENSOR WITH BUILT-IN ISOLATOR 10cm DIA [LOCATED AT CEILING]
⏏	ADDRESSABLE SOUNDER
⏏	ADDRESSABLE MANUAL CALL POINT 150cm FROM F.F.L
⏏	CONSOLIDATION POINTS (8 Nos. RJ 45) [LOCATED AT HIGH LEVEL]
⏏	T.V SOCKET OUTLET [LOCATED AT 45cm FROM F.F.L]
⏏	RJ11 TELEPHONE SOCKET OUTLET [WITH TWO BOX] [LOCATED AT 45 cm FROM F.F.L]


GENERAL NOTES

- This drawing is indicative only (not to be used for construction)and is accurate as at the date shown on the drawing .
- This drawing is subject to change as planning , development and construction continues through until opening of the center .
- It is the responsibility of the recipient of this drawing to update themselves with any subsequent reviews , updates , additions , deletions and / or substitution .
- It is the responsibility of the investor to undertake an on-site measure to verify all dimension shown on the drawing .
- Tamdeen Shopping Centers CO K.S.C.C . (or any of it's affiliated companies) does not accept any liability of any form for the recipient's use and / or interpretation of this drawing.

NORTH DIRECTION

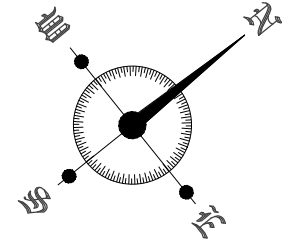

KEY PLAN

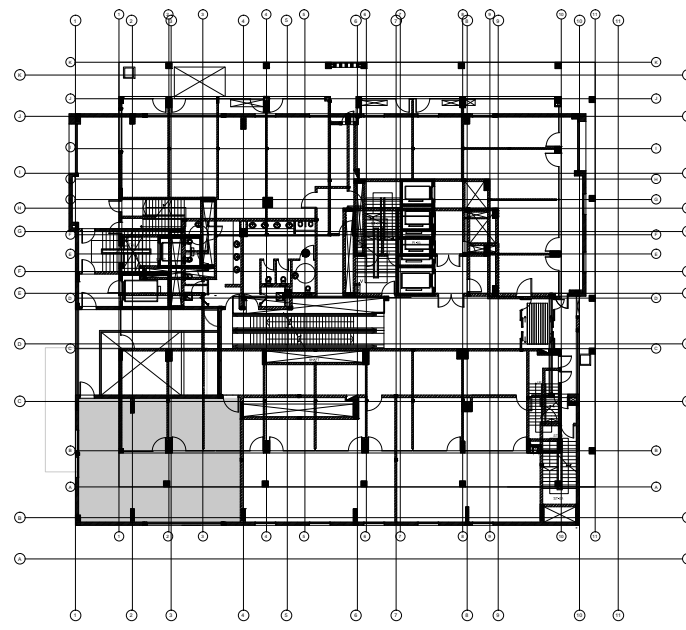

AS BUILT

OWNER : **تمددين**
TAMDEEN
SHOPPING CENTERS

MANAGE BY
gla management
GLA Property Management Co (LLC)
P O Box 230690, Safat 13151, Kuwait
+965 2536 9531 Tel
+965 2530 9531 Fax
rdd@gla.ae

CONSULTANT :
OH
OHA ENGINEERING CONSULTANT
P.O. Box 6249 HAWALLY , CODE NO.32037 - KUWAIT
PHONE: 22420508 - 22420518 FAX: 22436511
E-mail oha@ohaconsult.com

PROJECT NAME :
SAMA JAHRA

DRAWING TITLE :
SECOND FLOOR PLAN

OFFICE
UNIT NO - L2-05

DRAWN :	DESIGN :	DATE : MARCH -2017
SCALE : 1:50@A1	REVISED BY :	PAPER SIZE : A1
TRADE ELEC	REV. :	04