


Unit No	Btu/Hr	CFM	Servies Location	Model	BTU/Hr	CFM	KW	CU Length	CU Width	CU Height	CU Weight	FCU Length	FCU Width	FCU Height	FCU Weight	COMP. KW	COND. KW	EVAP. KW
FL2 - 05	71044	2000		38ARZ008/FB4ASSF070	71,044	2000	8.75	1504	1157	948	192	1503	560	537	80	7.58	0.47	0.7


GENERAL NOTES

- This drawing is indicative only (not to be used for construction) and is accurate as at the date shown on the drawing .
- This drawing is subject to change as planning ,development and construction continues through until opening of the center .
- It is the responsibility of the recipient of this drawing to update themselves with any subsequent reviews , updates , additions , deletions and / or substitution .
- It is the responsibility of the investor to undertake an on-site measure to verify all dimension shown on the drawing .
- Tamdeen Shopping Centers CO K.S.C.C . (or any of it's affiliated companies) does not accept any liability of any form for the recipient's use and / or interpretation of this drawing.

NORTH DIRECTION

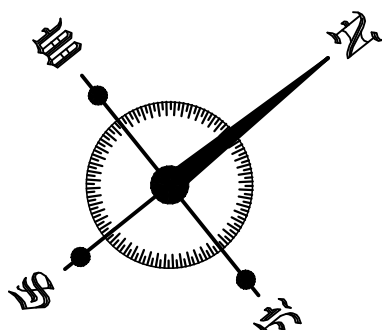

KEY PLAN

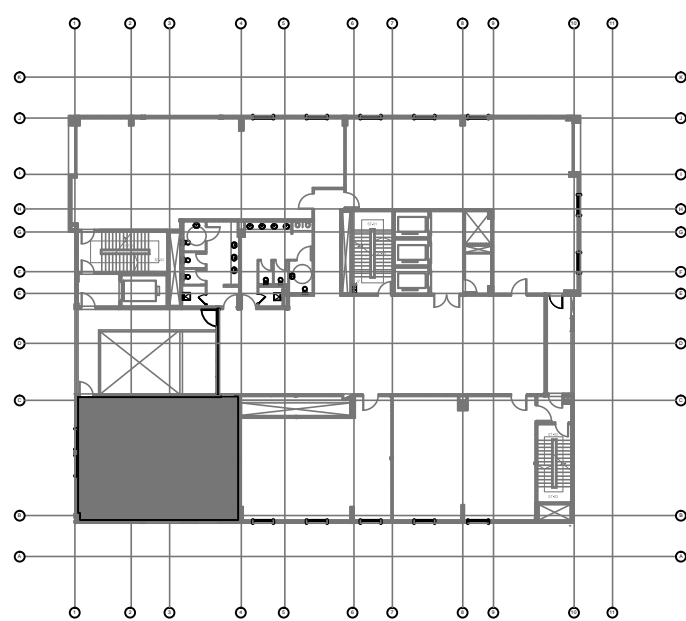

AS BUILT

OWNER :




MANAGE BY



GLA Property Management Co (LLC)
P O Box 29060, Safat 13151, Kuwait
+965 2530 9531 Tel
+965 2530 9531 Fax
rdd@gla.ae

CONSULTANT :

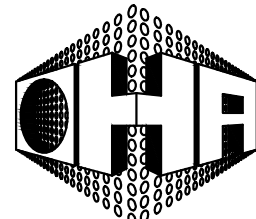

مكتب مهندسين
OHA ENGINEERING CONSULTANT
P. O. Box 6249 HAWALLY, CODE NO.32037 - KUWAIT
PHONE: 22420608 - 22420518 FAX: 22436511
E-mail oha@ohaconsult.com

PROJECT NAME :

SAMA JAHRA

DRAWING TITLE :

SECOND FLOOR PLAN

OFFICE
UNIT NO - L2-05

DRAWN :	DESIGN :	DATE : MAR-2017
SCALE : 1:50@A1	REVISED BY :	PAPER SIZE : A1
TRADE HVAC	REV. :	04