



GENERAL NOTES

- This drawing is indicative only (not to be used for construction) and is accurate as at the date shown on the drawing.
- This drawing is subject to change as planning, development and construction continues through until opening of the center.
- It is the responsibility of the recipient of this drawing to update themselves with any subsequent reviews, updates, additions, deletions and / or substitution.
- It is the responsibility of the investor to undertake an on-site measure to verify all dimension shown on the drawing.
- Tamdeen Shopping Centers CO K.S.C.C. (or any of its affiliated companies) does not accept any liability of any form for the recipient's use and / or interpretation of this drawing.

NORTH DIRECTION

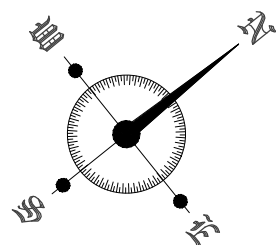

KEY PLAN

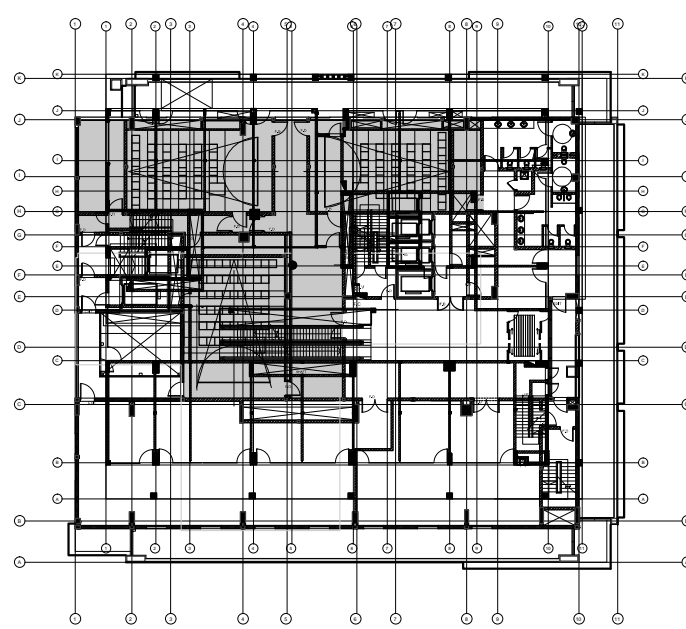

AS BUILT

OWNER : **تمدين**
TAMDEEN
SHOPPING CENTERS

MANAGE BY
gla management
GLA Property Management Co (LLC)
P.O. Box 23069, Safat 13151, Kuwait
+965 2536 9531 Tel
+965 2530 9531 Fax
rdd@gla.ae

CONSULTANT :
OHA ENGINEERING CONSULTANT
P.O. Box 6249 HAWALLY, CODE NO.32037 - KUWAIT
PHONE: 22420508 - 22420518 FAX: 22436511
E-mail: oha@ohaconsult.com

PROJECT NAME :
SAMA JAHRA

DRAWING TITLE :
FIRST FLOOR PLAN

CINEMA
UNIT NO - L1-03&4&5&6&7&8

DRAWN : DESIGN : DATE :
MARCH -2017

SCALE : 1:50@A1 REVISED BY : PAPER SIZE :
A1

TRADE ELEC REV. :
04

