



GENERAL NOTES

- This drawing is indicative only (not to be used for construction)and is accurate as at the date shown on the drawing .
- This drawing is subject to change as planning , development and construction continues through until opening of the center .
- It is the responsibility of the recipient of this drawing to update themselves with any subsequent reviews , updates , additions , deletions and / or substitution .
- It is the responsibility of the investor to undertake an on-site measure to verify all dimension shown on the drawing .
- Tamdeen Shopping Centers CO K.S.C.C . (or any of it's affiliated companies) does not accept any liability of any form for the recipient's use and / or interpretation of this drawing.

NORTH DIRECTION

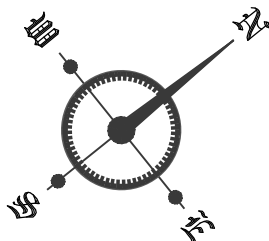

KEY PLAN

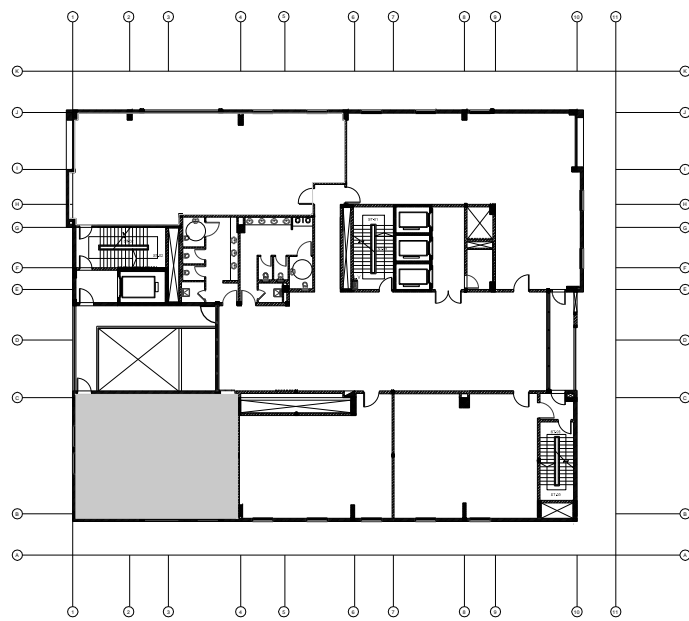

AS BUILT

OWNER :

MANAGE BY

GLA Property Management Co (LLC)
P O Box 29060, Safat 13151, Kuwait
+965 2536 9531 Tel
+965 2530 9531 Fax
rdd@gl.ae

CONSULTANT :

مكتب عومة الاستشارات الهندسية
OHA ENGINEERING CONSULTANT
P. O. Box 6049 HAWALLY , CODE NO.32037 - KUWAIT
PHONE: 22420508 - 22420518 FAX: 22436511
E-mail oha@ohaconsult.com

PROJECT NAME :
SAMA JAHRA

DRAWING TITLE :
SECOND FLOOR PLAN

OFFICE UNIT NO - L2-05 FIRE PROTECTION SYSTEM		
DRAWN :	DESIGN :	DATE : MAR-2017
SCALE : 1:50@A1	REVISED BY :	PAPER SIZE : A1
TRADE MECH FP-01	REV. : 04	