


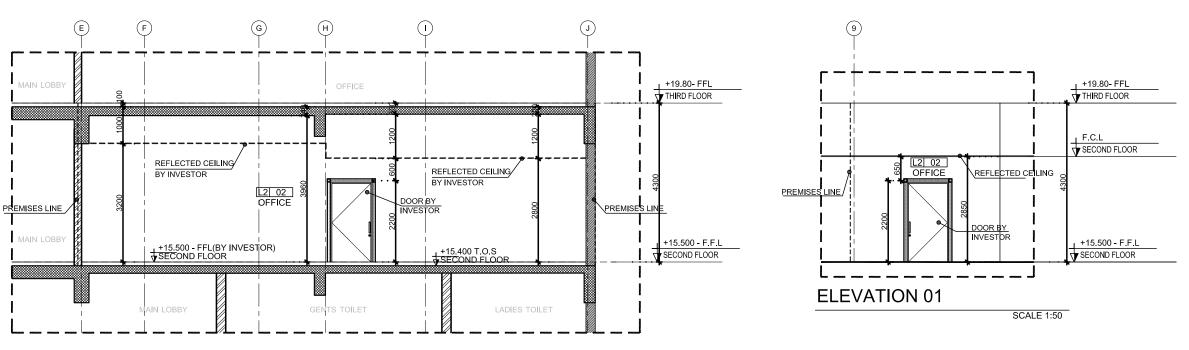

**SECTION B-B** 

SCALE 1:50




## **GENERAL NOTES**

- This drawing is indicative only (not to be used for construction ) and is accurate as at the date shown on the drawing .
- This drawing is subject to change as planning , development and construction continues through until opening of the center .
- It is the responsibility of the recipient of this drawing to update themselves with any subsequent reviews , updates , additions , deletions and / or substitution .
- It is the responsibility of the investor to undertake an on-site measure to verify all dimension shown on the drawing.
- Tamdeen Shopping Centers CO K.S.C.C. ( or any of it's affiliated companies ) does not accept any liability of any form for the recipient's use and / or interpretation of this drawing.

### NORTH DIRECTION



## **KEY PLAN**

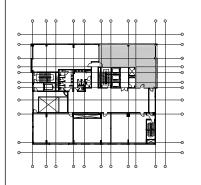

# **AS BUILT**

OWNER



#### MANAGE BY



GLA Property Management Co (LLC) P O Box 29060, Safat 13151,Kuwalt +965 2536 9531 Tel +965 2530 9531 Fax

### CONSULTANT:



OHA ENGINEERING CONSULTANT
P.O. Sen 6249 HAWALLY, CODE NO.30377 - KUWAIT
PHONE: 22426581 - EAX: 22436511
E-mail oha@daroha.com

#### PROJECT NAME:

SAMA JAHRA

## DRAWING TITLE :

SECOND FLOOR PLAN

OFFICE			
UNIT NO - L2-02			

DRAWN:	DESIGN:	MAR - 2017	
SCALE: 1:50@A1	REVISED BY:	PAPER SIZE :	A1

TRADE REV.: