

S.NO	DESCRIPTION	LOAD IN K.W
1	LIGHT	1.69 K.W
2	POWER	1.20 K.W
3	A/C	10.240 K.W
	TOTAL LOAD	13.13 K.W




	LIGHT POINT
	EMERGENCY LIGHT FITTING
	EXIT SIGN BOARD FITTING
	ONE WAY SWITCH (LOCATED AT 140mm FROM F.F.L)
	D.B (DISTRIBUTION BOARD LOCATED AT 180mm FROM F.F.L)
	13A, 3PIN, 240V, TWIN SWITCHED SOCKET OUTLET (LOCATED AT 45 mm FROM F.F.L)
	13A, 3PIN, 240V, SINGLE SWITCHED SOCKET OUTLET (LOCATED AT 45 mm FROM F.F.L)
	A/C DB (LOCATED AT ABOVE CEILING)
	ADDRESSABLE SMOKE SENSOR WITH BUILT-IN ISOLATOR 15mm DIA (LOCATED AT CEILING)
	ADDRESSABLE SOUNDER
	ADDRESSABLE MANUAL CALL POINT 150mm FROM F.F.L
	CONSOLIDATION POINTS (8 Nos. RJ 45) (LOCATED AT HIGH LEVEL)
	T.V SOCKET OUTLET (LOCATED AT 45mm FROM F.F.L)
	RJ11 TELEPHONE SOCKET OUTLET (WITH TWO BOX) (LOCATED AT 45 mm FROM F.F.L)


GENERAL NOTES

- This drawing is indicative only (not to be used for construction)and is accurate as at the date shown on the drawing .
- This drawing is subject to change as planning , development and construction continues through until opening of the center .
- It is the responsibility of the recipient of this drawing to update themselves with any subsequent reviews , updates , additions , deletions and / or substitution .
- It is the responsibility of the investor to undertake an on-site measure to verify all dimension shown on the drawing .
- Tamdeen Shopping Centers CO K.S.C.C . (or any of it's affiliated companies) does not accept any liability of any form for the recipient's use and / or interpretation of this drawing.

NORTH DIRECTION

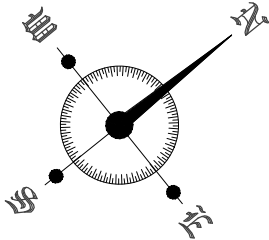

KEY PLAN

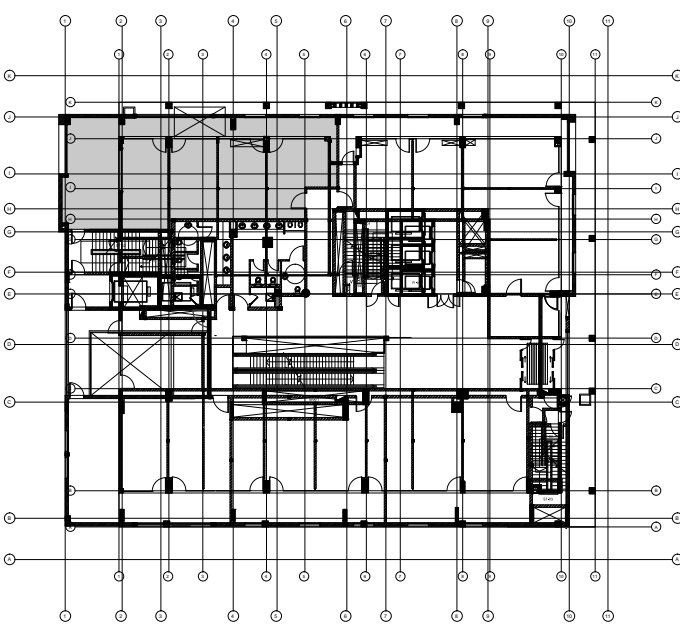

AS BUILT

OWNER : **تمدين TAMDEEN SHOPPING CENTERS**

MANAGE BY **gla management**
GLA Property Management Co (LLC)
P O Box 29060, Safat 13151, Kuwait
+965 2536 9531 Tel
+965 2530 9531 Fax
rdd@gla.ae

CONSULTANT : **OHHA ENGINEERING CONSULTANT**
P.O. Box 6249 HAWALLY , CODE NO.32037 - KUWAIT
PHONE: 22420508 - 22420518 FAX: 22436511
E-mail oha@ohaconsult.com

PROJECT NAME : **SAMA JAHRA**

DRAWING TITLE : **SECOND FLOOR PLAN**

OFFICE UNIT NO - L2-01

DRAWN :	DESIGN :	DATE : MARCH -2017
SCALE : 1:50@A1	REVISED BY :	PAPER SIZE : A1
TRADE ELEC	REV. :	04