



SECTION A-A

SCALE 1:50

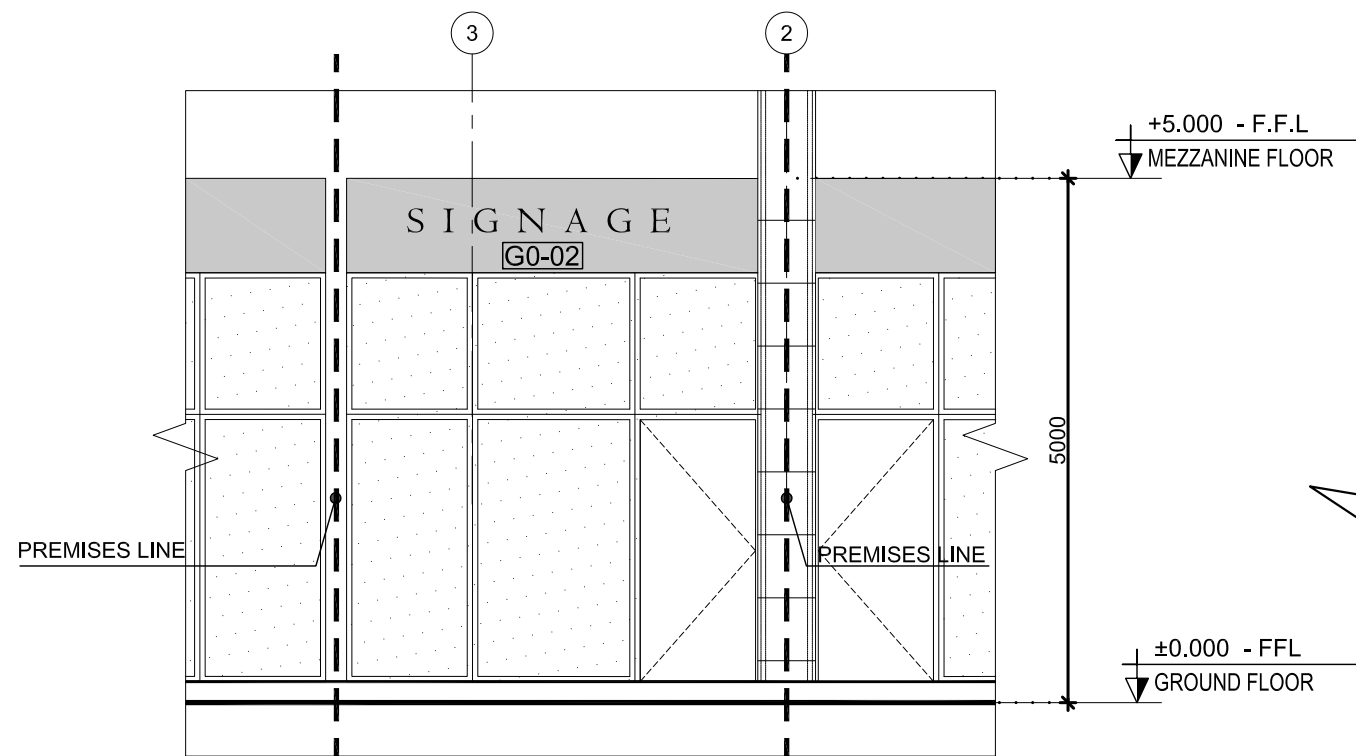

ELEVATION (01)

SCALE 1:50

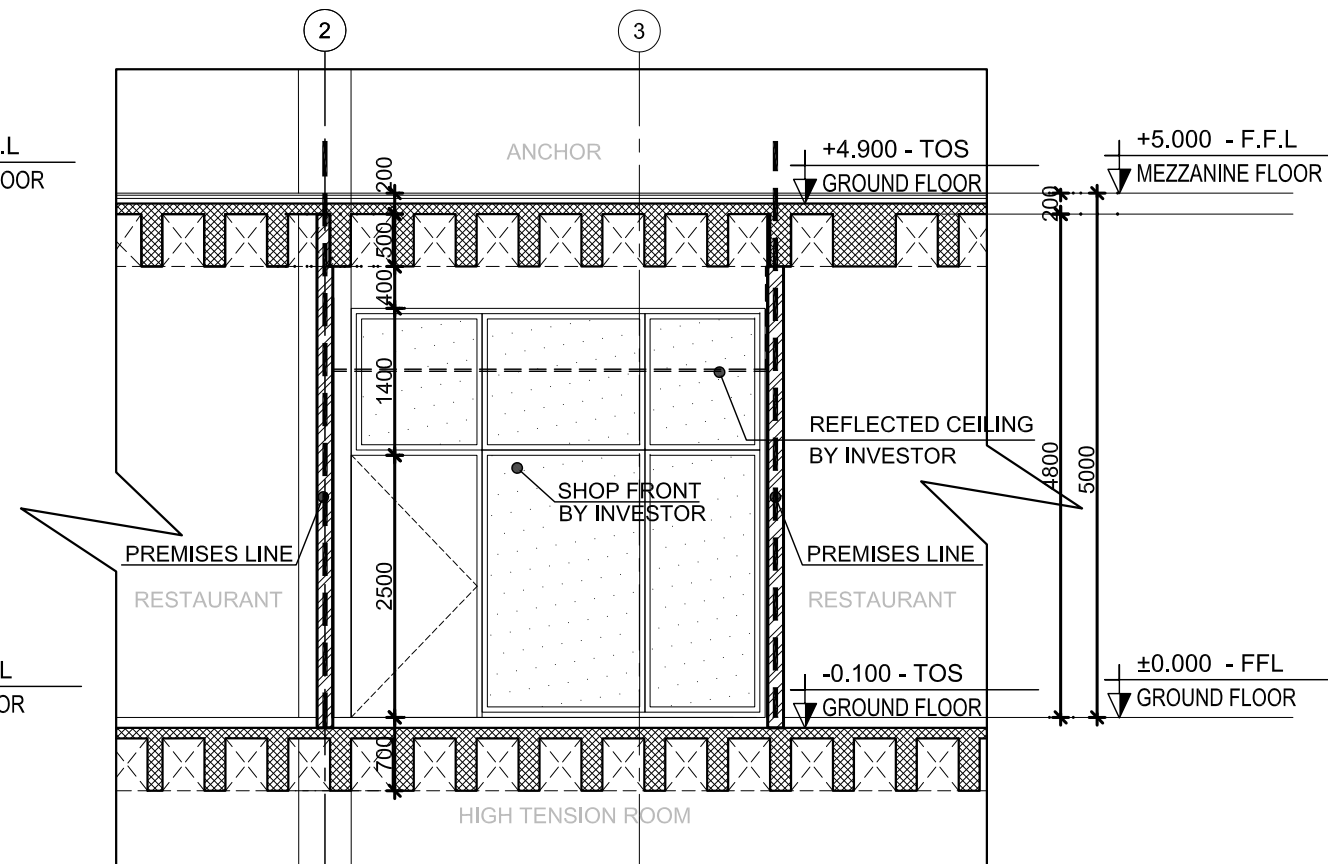


SECTION B-B

SCALE 1:50


GENERAL NOTES

- This drawing is indicative only (not to be used for construction) and is accurate as at the date shown on the drawing.
- This drawing is subject to change as planning, development and construction continues through until opening of the center.
- It is the responsibility of the recipient of this drawing to update themselves with any subsequent reviews, updates, additions, deletions and / or substitution.
- It is the responsibility of the investor to undertake an on-site measure to verify all dimension shown on the drawing.
- Tamdeen Shopping Centers CO K.S.C.C. (or any of its affiliated companies) does not accept any liability of any form for the recipient's use and / or interpretation of this drawing.

NORTH DIRECTION

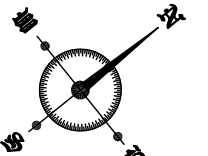

KEY PLAN

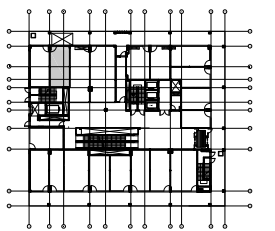

AS BUILT

OWNER : **تَمْدِين**
TAMDEEN
SHOPPING CENTERS

MANAGE BY
gla management
GLA Property Management Co (LLC)
P O Box 29060, Safat 13151, Kuwait
+965 2536 9531 Tel
+965 2530 9531 Fax
rdd@gla.ae

CONSULTANT :
CHH **CHH ENGINEERING CONSULTANT**
P.O. Box 6249 HAILU, CODE NO.3207 - KUWAIT
PHONE: 22420008 - 22420518 FAX: 22435511
E-mail: chh@daroha.com

PROJECT NAME :
SAMA JAHRA

DRAWING TITLE :
GROUND FLOOR PLAN

RESTAURANT
UNIT NO - G0-02

DRAWN :	DESIGN :	DATE : MAR-2017
SCALE : 1:50@A2	REVISED BY :	PAPER SIZE : A2
TRADE : ARCH-SEC/ELEV-02	REV. :	04