



GENERAL NOTES

- This drawing is indicative only (not to be used for construction)and is accurate as at the date shown on the drawing .
- This drawing is subject to change as planning , development and construction continues through until opening of the center .
- It is the responsibility of the recipient of this drawing to update themselves with any subsequent reviews , updates , additions , deletions and / or substitution .
- It is the responsibility of the investor to undertake an on-site measure to verify all dimension shown on the drawing .
- Tamdeen Shopping Centers CO K.S.C.C . (or any of it's affiliated companies) does not accept any liability of any form for the recipient's use and / or interpretation of this drawing.

NORTH DIRECTION

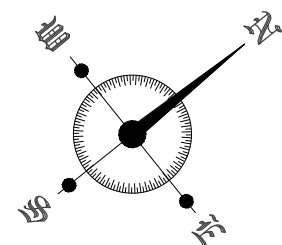

KEY PLAN

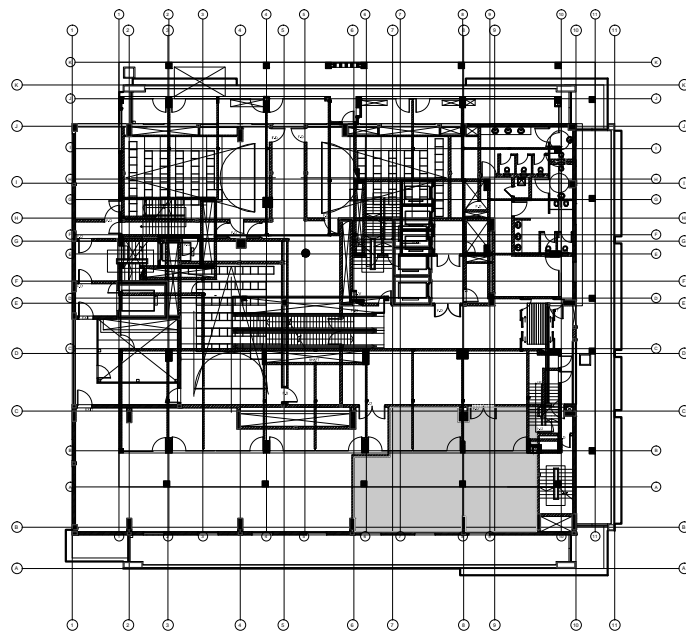

AS BUILT

OWNER : **تمدين TAMDEEN**
SHOPPING CENTERS

MANAGE BY **gla management**
GLA Property Management Co (LLC)
P O Box 23060, Safat 13151, Kuwait
+965 2536 9531 Tel
+965 2530 9531 Fax
rdd@gla.ae

CONSULTANT : **OHA ENGINEERING CONSULTANT**
P.O. Box 6249 HAWALLY , CODE NO.32037 - KUWAIT
PHONE: 22420508 - 22420518 FAX: 22436511
E-mail oha@ohaconsult.com


PROJECT NAME : **SAMA JAHRA**

DRAWING TITLE : **FIRST FLOOR PLAN**

INSTITUTE/ENTERTAINMENT
UNIT NO - L1-01

DRAWN :	DESIGN :	DATE : MARCH -2017
SCALE : 1:50@A1	REVISED BY :	PAPER SIZE : A1
TRADE ELEC	REV. :	04

S.NO	DESCRIPTION	LOAD IN K.W
1	LIGHT	1.32 K.W
2	POWER	1.40 K.W
3	A/C	15.63 K.W
	TOTAL LOAD	18.35 K.W

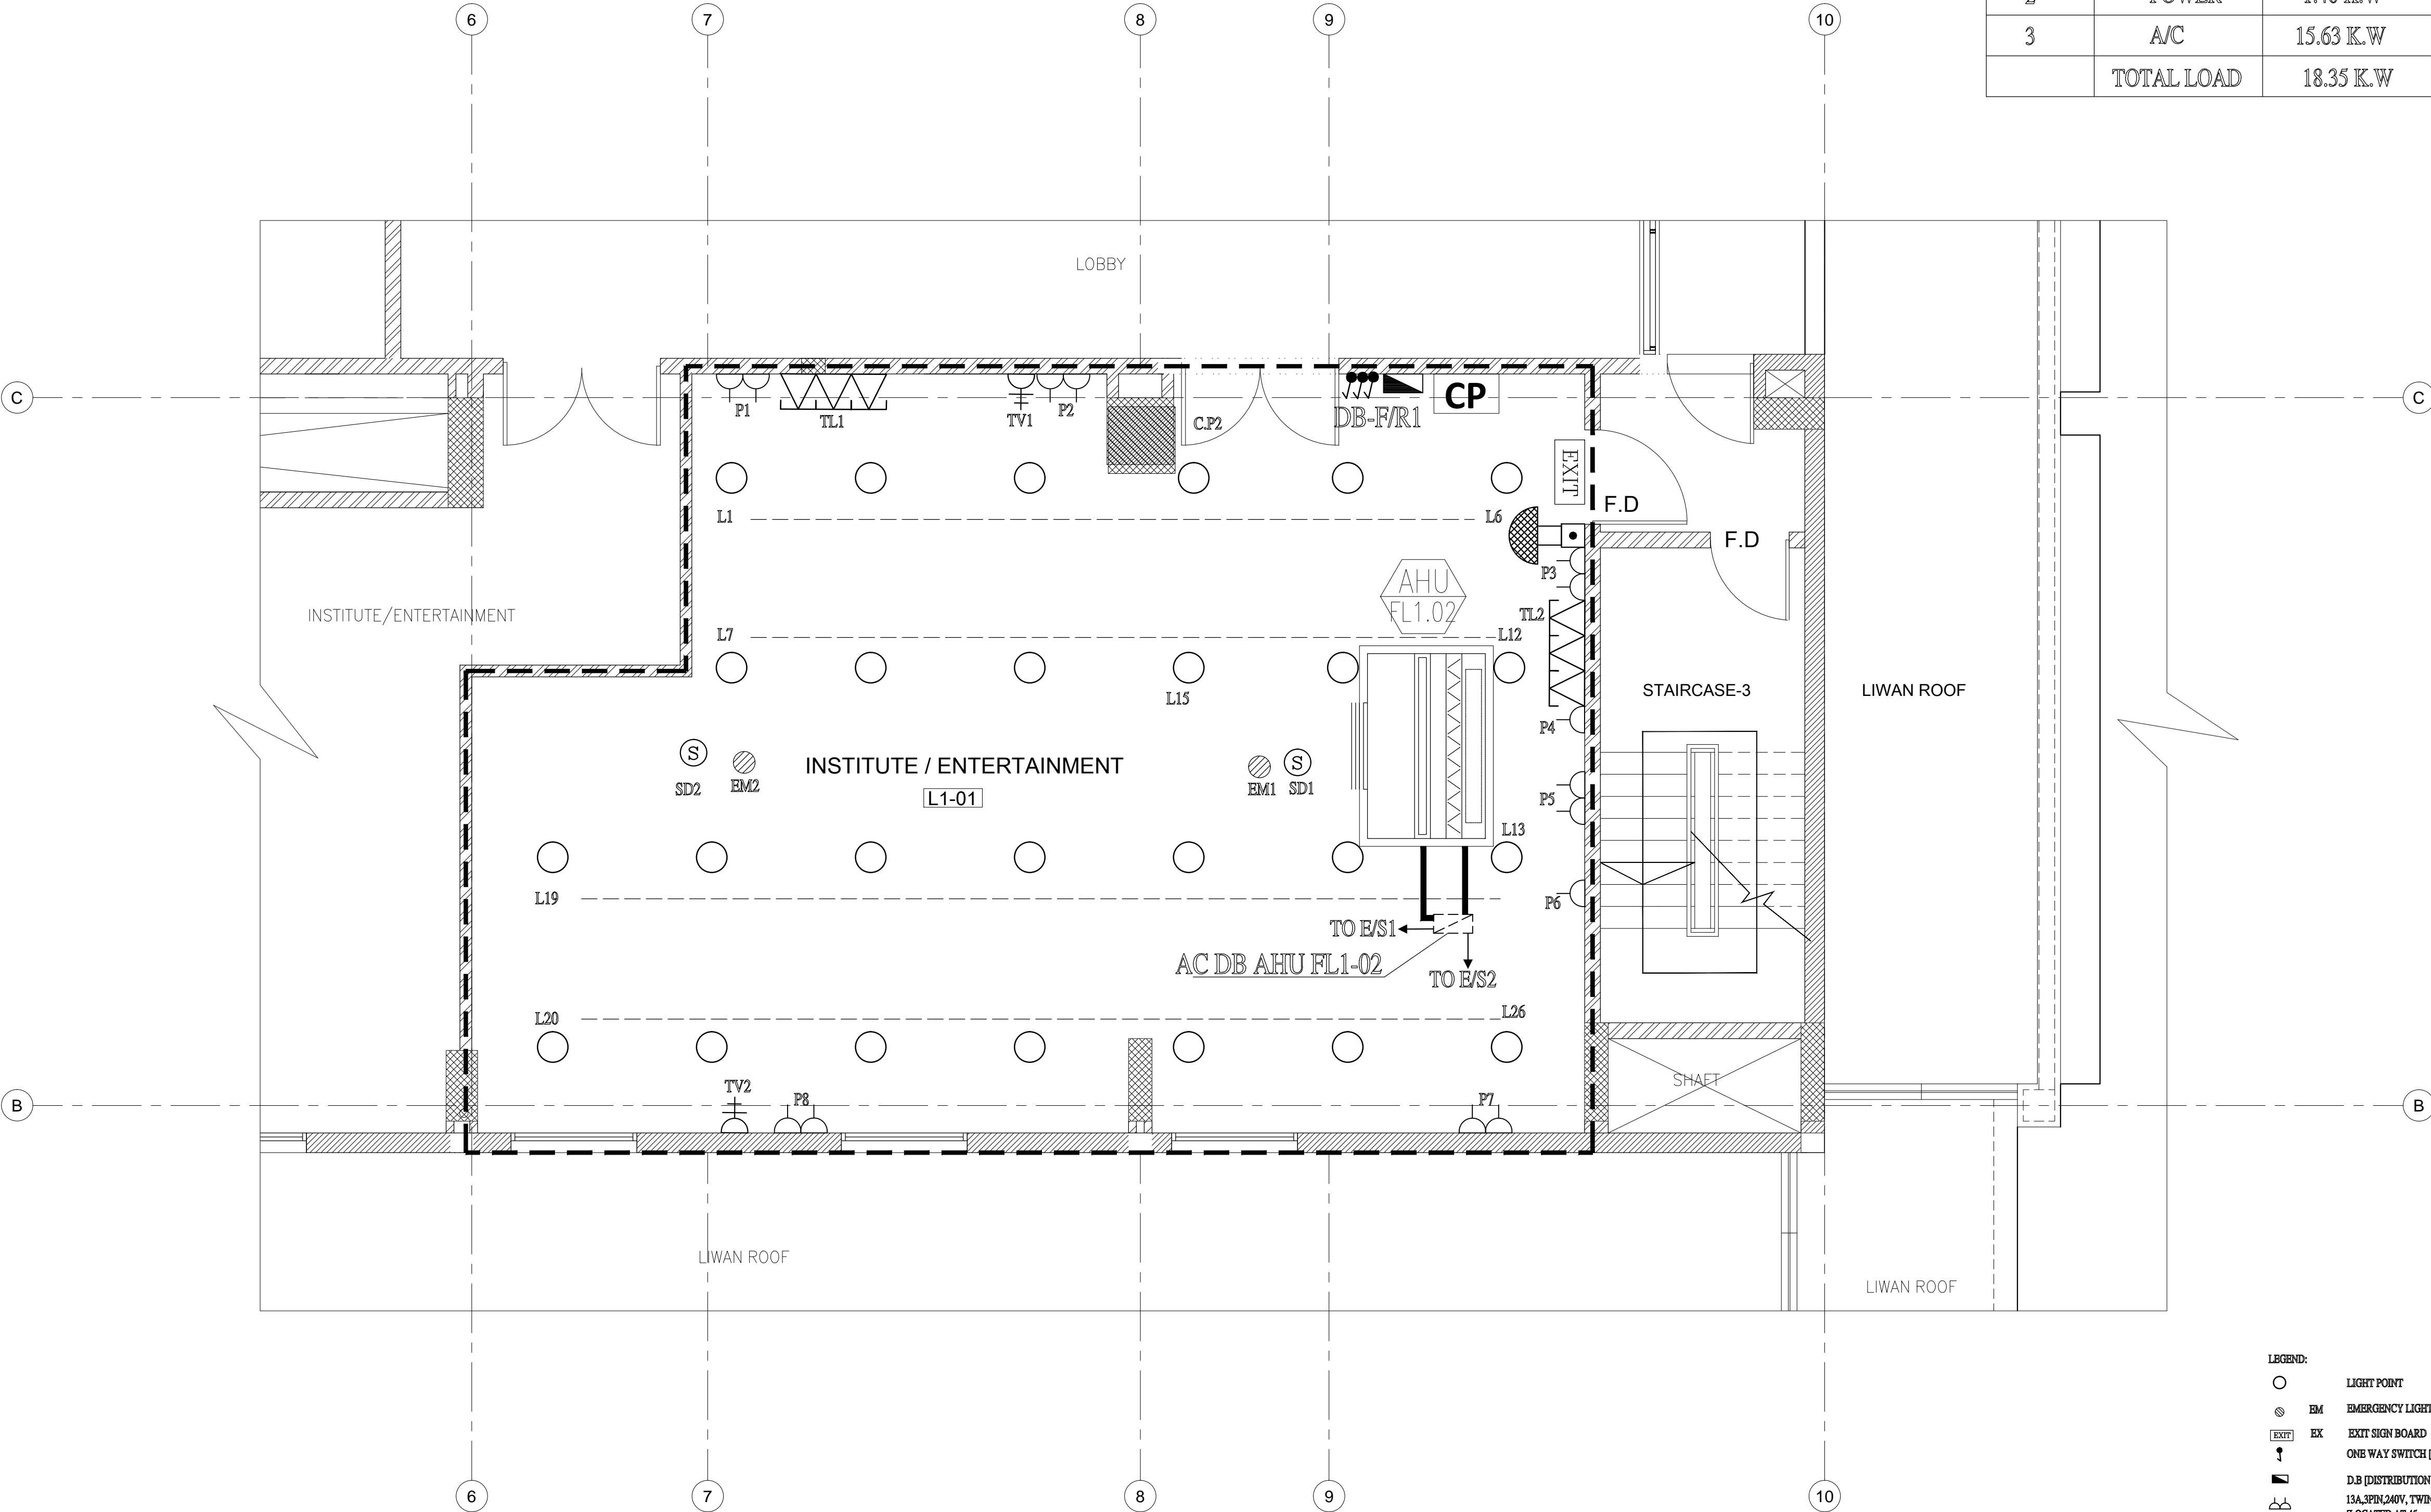

- LEGEND:
- LIGHT POINT
 - EM EMERGENCY LIGHT FITTING
 - EXIT EXIT SIGN BOARD
 - ONE WAY SWITCH (LOCATED AT 140cm FROM F.F.L)
 - D.B (DISTRIBUTION BOARD LOCATED AT 180cm FROM F.F.L)
 - 13A,3PIN,240V, TWIN SWITCHED SOCKET OUTLET (LOCATED AT 45 cm FROM F.F.L)
 - 13A,3PIN,240V, SINGLE SWITCHED SOCKET OUTLET (LOCATED AT 45 cm FROM F.F.L)
 - A/C DB (LOCATED AT ABOVE CEILING)
 - ADDRESSABLE SMOKE SENSOR WITH BUILT-IN ISOLATOR 10cm DIA (LOCATED AT CEILING)
 - ADDRESSABLE MANUAL CALL POINT 150cm FROM F.F.L
 - ADDRESSABLE SOUNDER
 - CONSOLIDATION POINTS (8 Nos. RJ 45) (LOCATED AT HIGH LEVEL)
 - T.V SOCKET OUTLET (LOCATED AT 45cm FROM F.F.L)
 - RJ11 TELEPHONE SOCKET OUTLET (WITH TWO BOX) (LOCATED AT 45 cm FROM F.F.L)